


T.26S.,R.6W.,W.M.

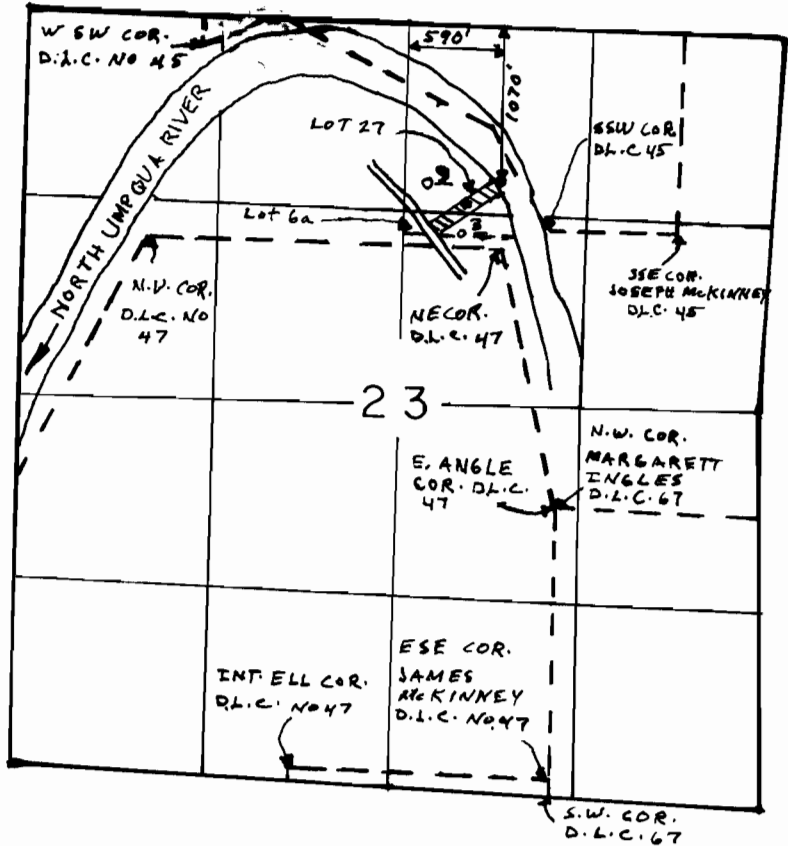

SCALE 1" = 1320'

FINAL PROOF SURVEY UNDER

THE PURPOSE OF THIS MAP IS TO IDENTIFY THE LOCATION OF THE WATER RIGHT. IT IS NOT INTENDED TO PROVIDE INFORMATION RELATIVE TO THE LOCATION OF PROPERTY OWNERSHIP BOUNDARY LINES.

Application No. 70375 Permit No. 51231
IN NAME OF

LEE BLOXHAM

Surveyed JUNE 19, 1991, by D.W. KIRBY

