


THIS MAP WAS PREPARED FOR THE PURPOSE OF IDENTIFYING THE LOCATION OF THE WATER RIGHT AND IS NOT INTENDED TO PROVIDE LEGAL DIMENSIONS OR LOCATIONS OF PROPERTY OWNERSHIP LINES.

T20S, R10E, W.M.

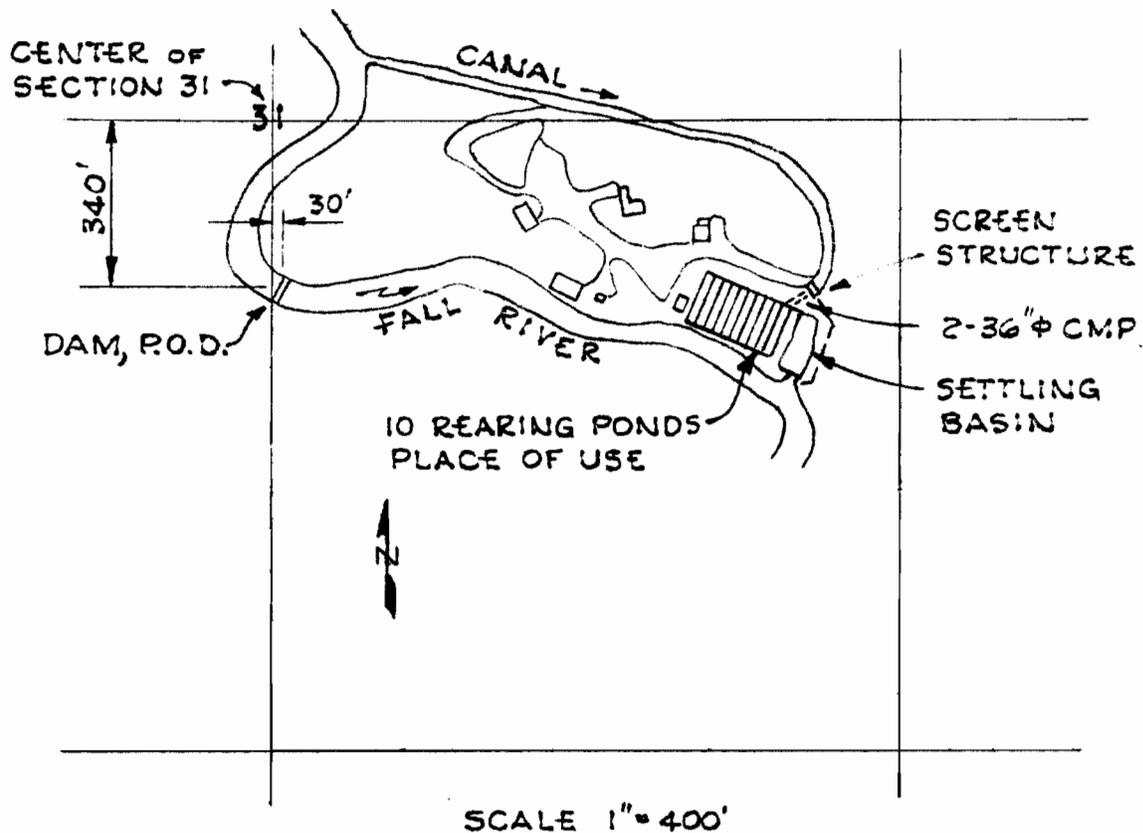

POD LOCATED 340' SOUTH AND 30' EAST OF THE CENTER OF SECTION 31.

FINAL PROOF SURVEY

UNDER

APPLICATION NO 71148 PERMIT NO 51220

IN NAME OF

OREGON DEPARTMENT OF FISH AND WILDLIFE

SURVEYED JUNE 4, 1991

BY DODGE

