


# T.1S. R.38E. W.M.

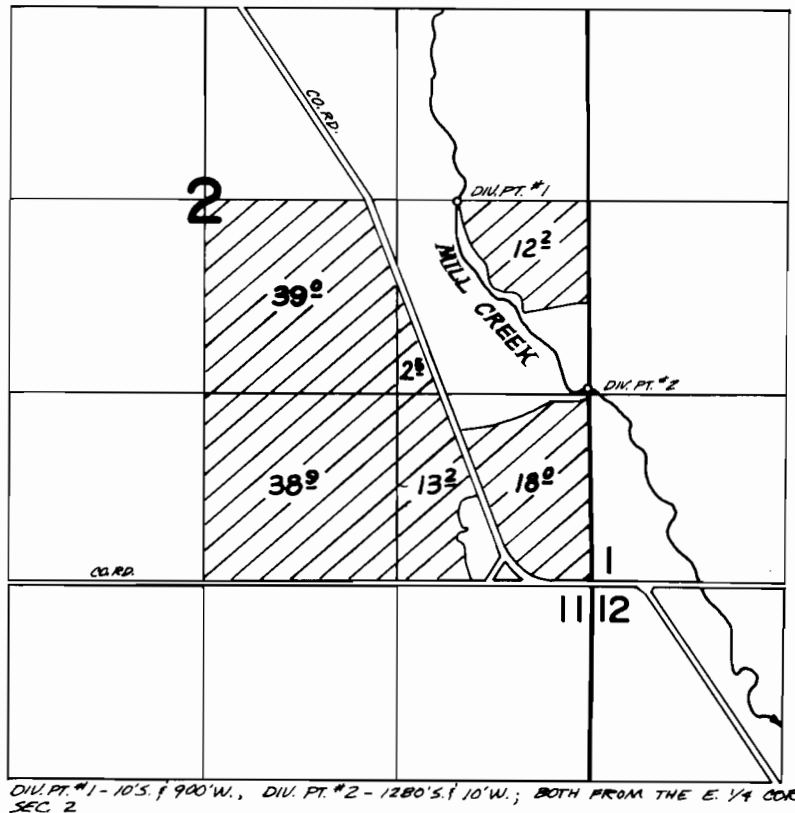


## FINAL PROOF SURVEY UNDER

Application No. 49357 Permit No. 36518  
IN NAME OF

Fredrick L. Behrens

Surveyed April 2, 1975, by D. Norby