


T. 37 & 38 S., R. 2 W., W. M.

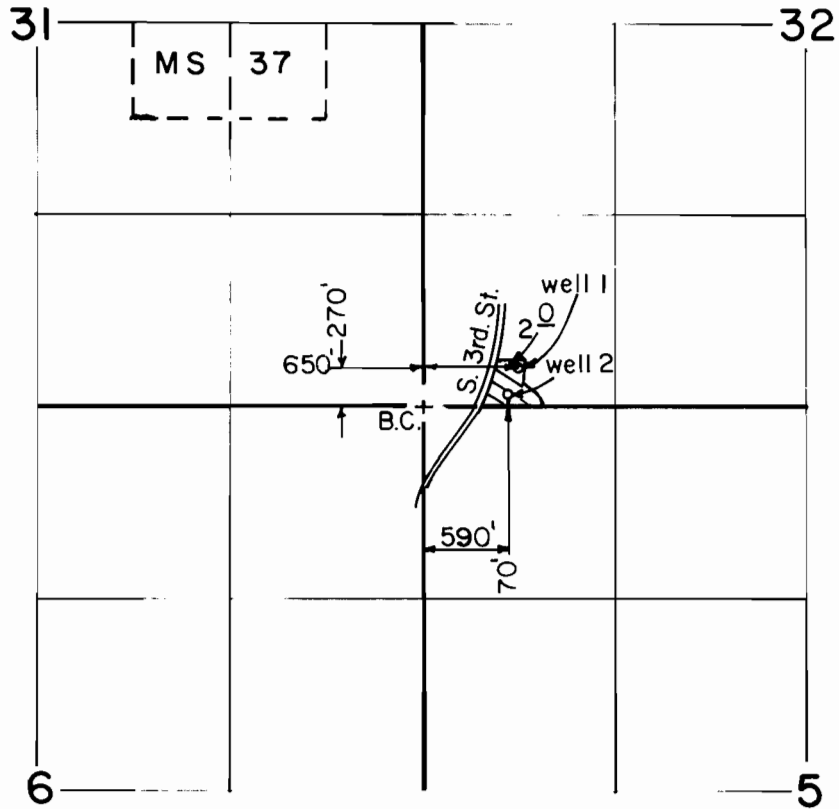

Scale: 1" = 1320'

FINAL PROOF SURVEY
UNDER

Application No. G:7881 Permit No. G:7213...
IN NAME OF

ANDREW... & ...JOSEPHINE...OWINGS

Surveyed JULY...9.. 1991., by B. S...JAMES....