


T. 37 & 38 S., R. 4 W., W. M.

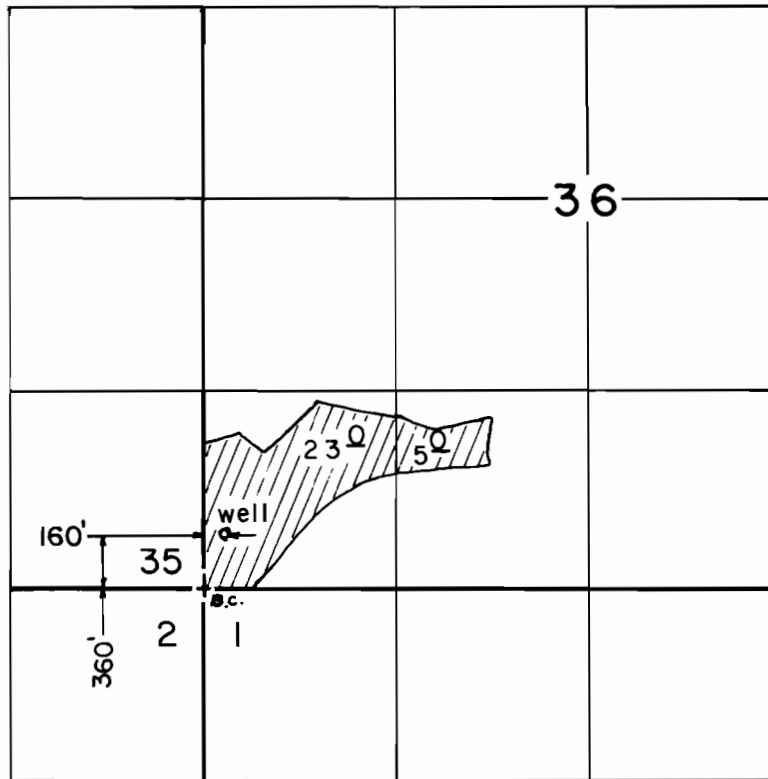

Scale: 1" = 1320'

FINAL PROOF SURVEY
UNDER

Application No. G-9923 Permit No. G-9131....
IN NAME OF

ALOYSIUS & ELSIE CHACHERE

Surveyed SEP. 17.. 1991., by L.M. JOACHIMS