


T. 32 & 33 S. R. 6 & 7 W. W. M.

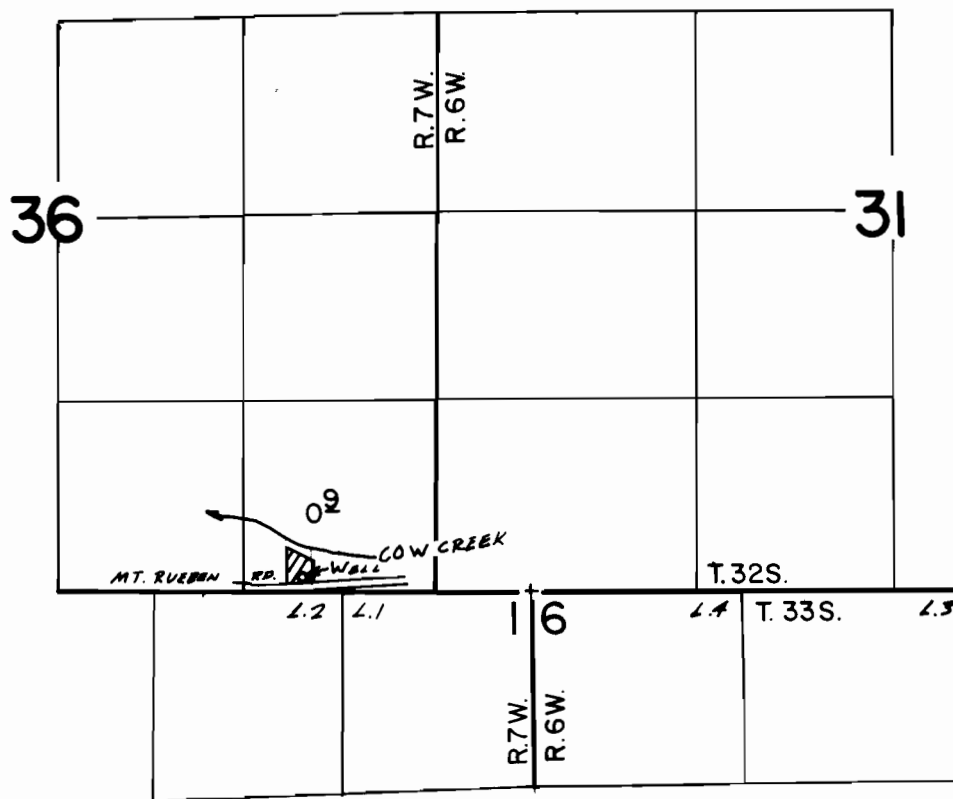

WELL : 100' N & 870' W FROM THE SW COR. OF SEC. 36, T. 32 S., R. 7 W., W. M.

Scale 1" = 1320'

FINAL PROOF SURVEY UNDER

Application No. G-10796 Permit No. G-9894..
IN NAME OF

..... JUDITH ANN McCORD

Surveyed July 24, 1990., by L.M. JOACHIMS
July 31, 1990