


T. 35 S., R. 1 W., W. M.

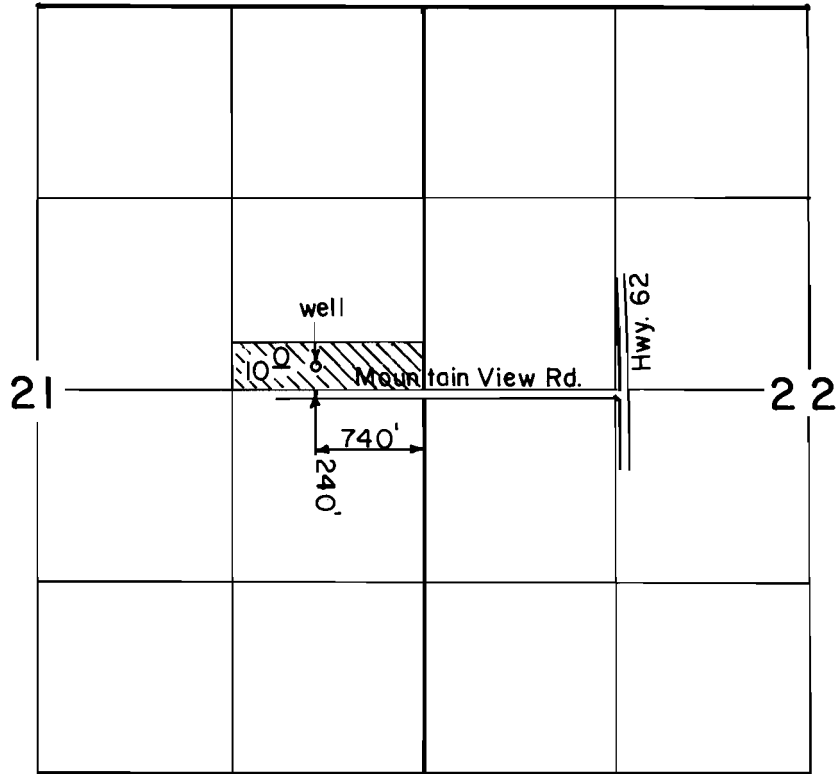

Scale: 1" = 1320'

FINAL PROOF SURVEY
UNDER

Application No. G-11001. Permit No. G-10251....
IN NAME OF

...QUINTON.....R.....MATTHEWS....

Surveyed JUNE 25 1991., by L.M. JOACHIMS