


T. 37 S., R. 2 W., W. M.

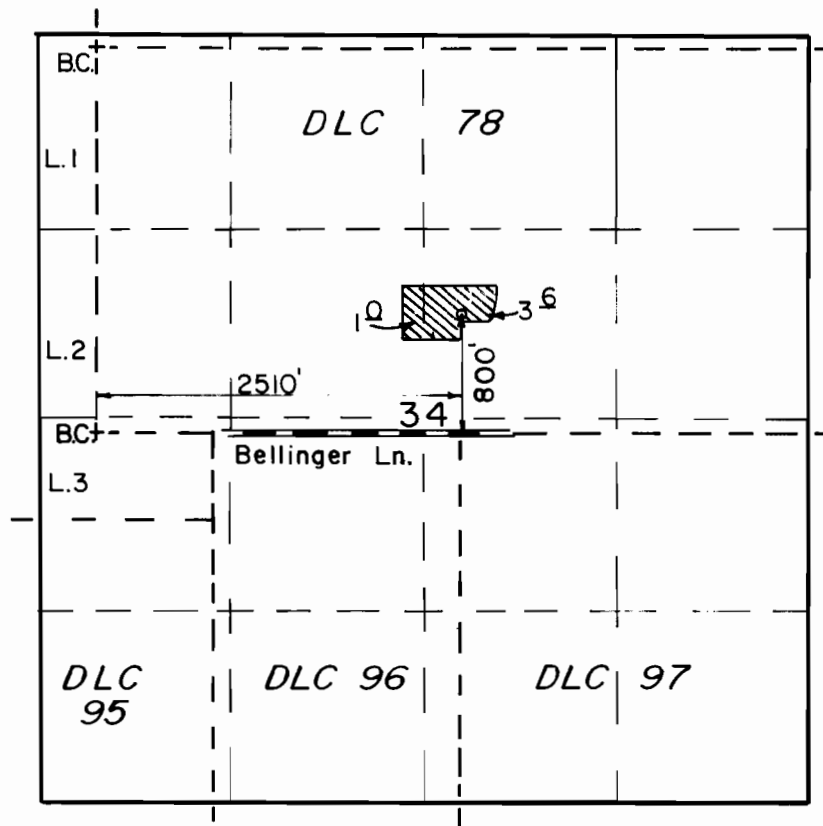

Scale: 1" = 1320'

FINAL PROOF SURVEY
UNDER

Application No. G-11078 Permit No. G-10188...
IN NAME OF

.....RONALD.....D.....FARRAR.....

Surveyed JULY..9.. 1991.., by B.S..JAMES....