


# T.36&37S., R.14E., W.M.

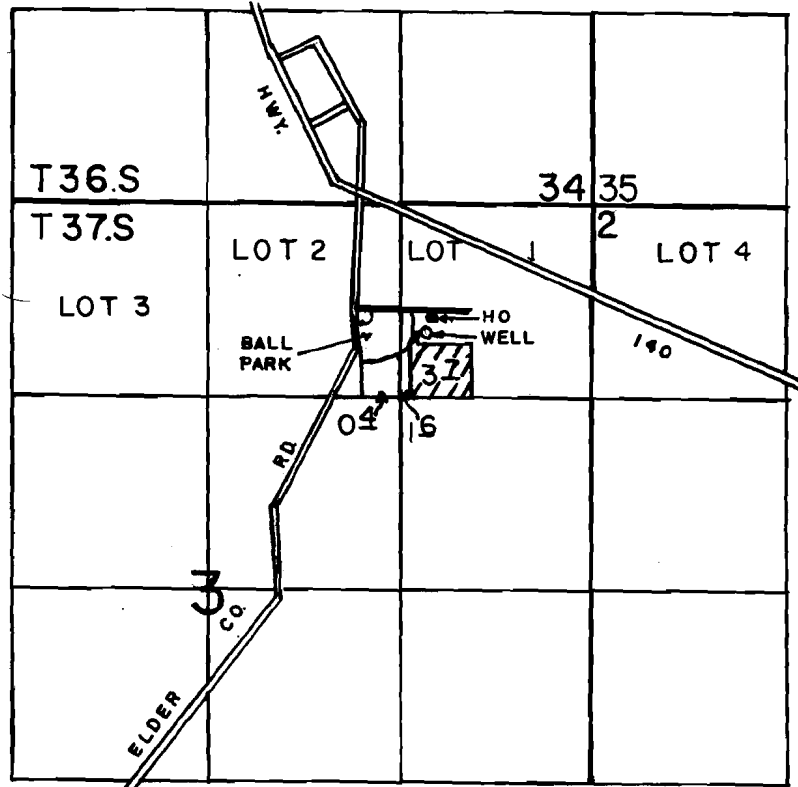

WELL LOC.: 890' S. & 1140' W. FROM NE COR. OF SEC 3.

SCALE: 1" = 1320'

## FINAL PROOF SURVEY UNDER

Application No. G-11115 Permit No. G-10333  
IN NAME OF

MARTIN O. MELSNESS

Surveyed MAY 1, 1991, by B. W. BISHOP

Fishhole Creek Wells