


T. 38 S., R. 2 W., W. M.

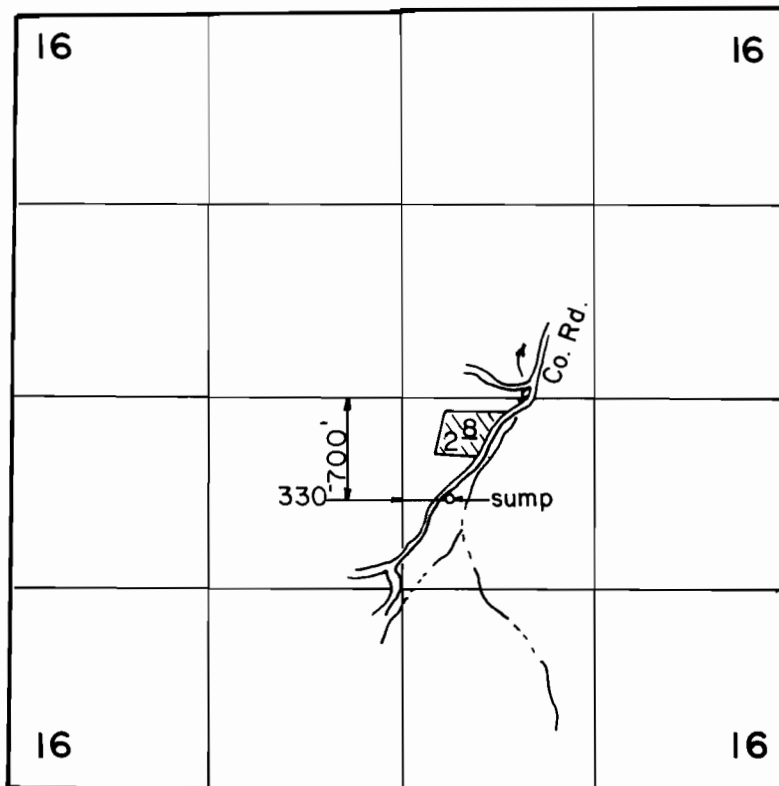

Scale: 1" = 1320'

FINAL PROOF SURVEY
UNDER

Application No. G:11174 Permit No. G:10276.
IN NAME OF

.....FREDERICK G. FRASER.....

Surveyed NOV. 7, 1991, by L.M. JOACHIMS