


G-10558
68020

T. 10S., R. 30E., W.M.

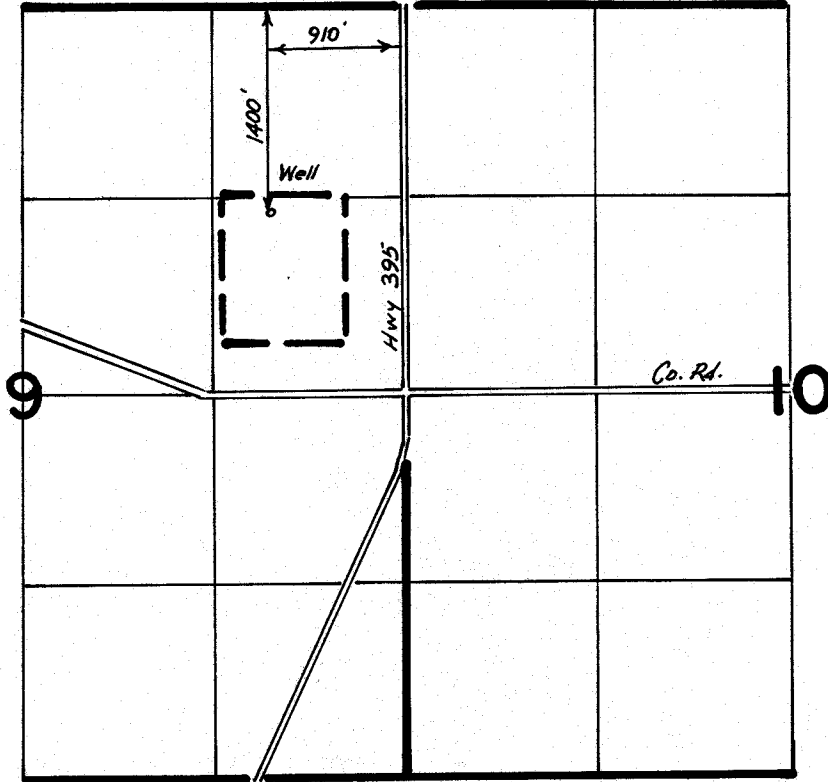

FINAL PROOF SURVEY UNDER

Scale: 1" = 1320'

Application No. G11448 Permit No. G10558
IN NAME OF

BLUE MOUNTAIN FOREST PRODUCTS

Surveyed 8-22 1990, by H. Kemp