


T. 29S., R. 5W., W.M.

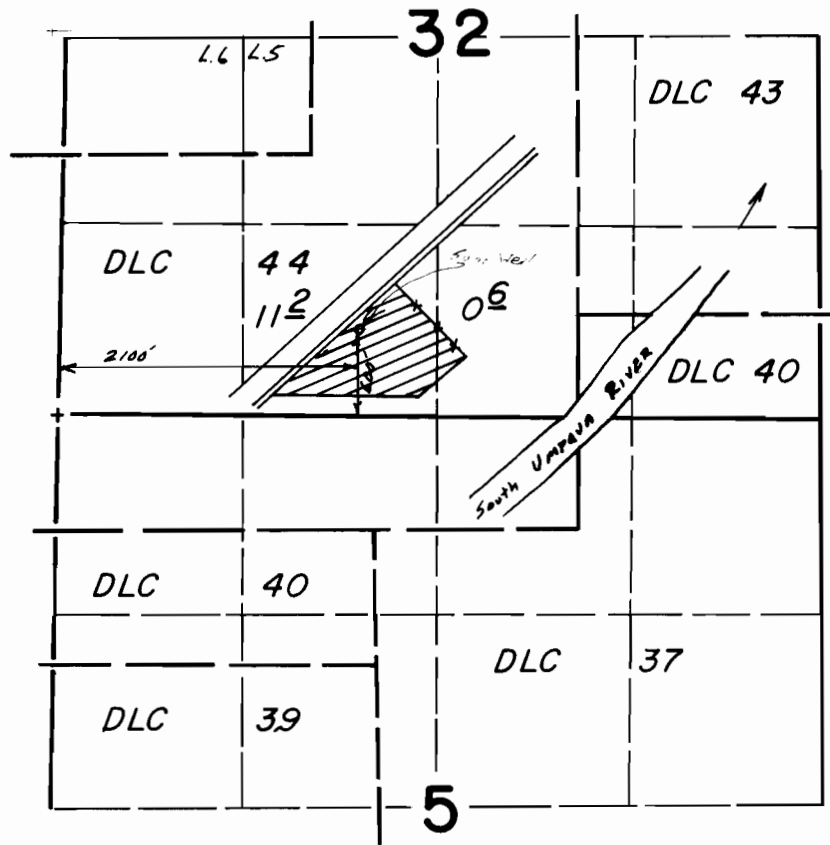

Scale 1" = 1320'

**FINAL PROOF SURVEY  
UNDER**

Application No. G-11511 Permit No. G-10644  
IN NAME OF

HARMON WALKER

Surveyed April 24, 1990, by S. James