


31624

68022

T. 36, R. 13 E., W.M.

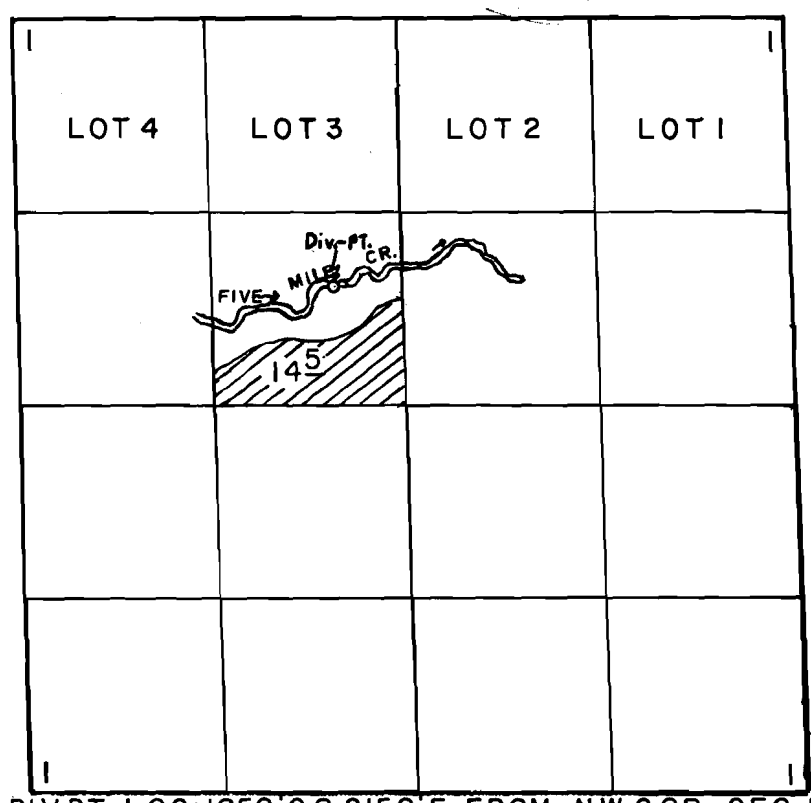

DIV. PT LOC: 1850' S & 2150' E FROM NW COR. SEC. 1

SCALE: 1" = 1320'

FINAL PROOF SURVEY UNDER

Application No. 48883 Permit No. 36624.....
IN NAME OF

.....PAUL WILLIAM SIMONSEN.....

Surveyed JUNE 6 1991, by B.W. BISHOP.

W. H. Wagoner & Son, Inc.