


T.33S.,R.7½E.,W.M.

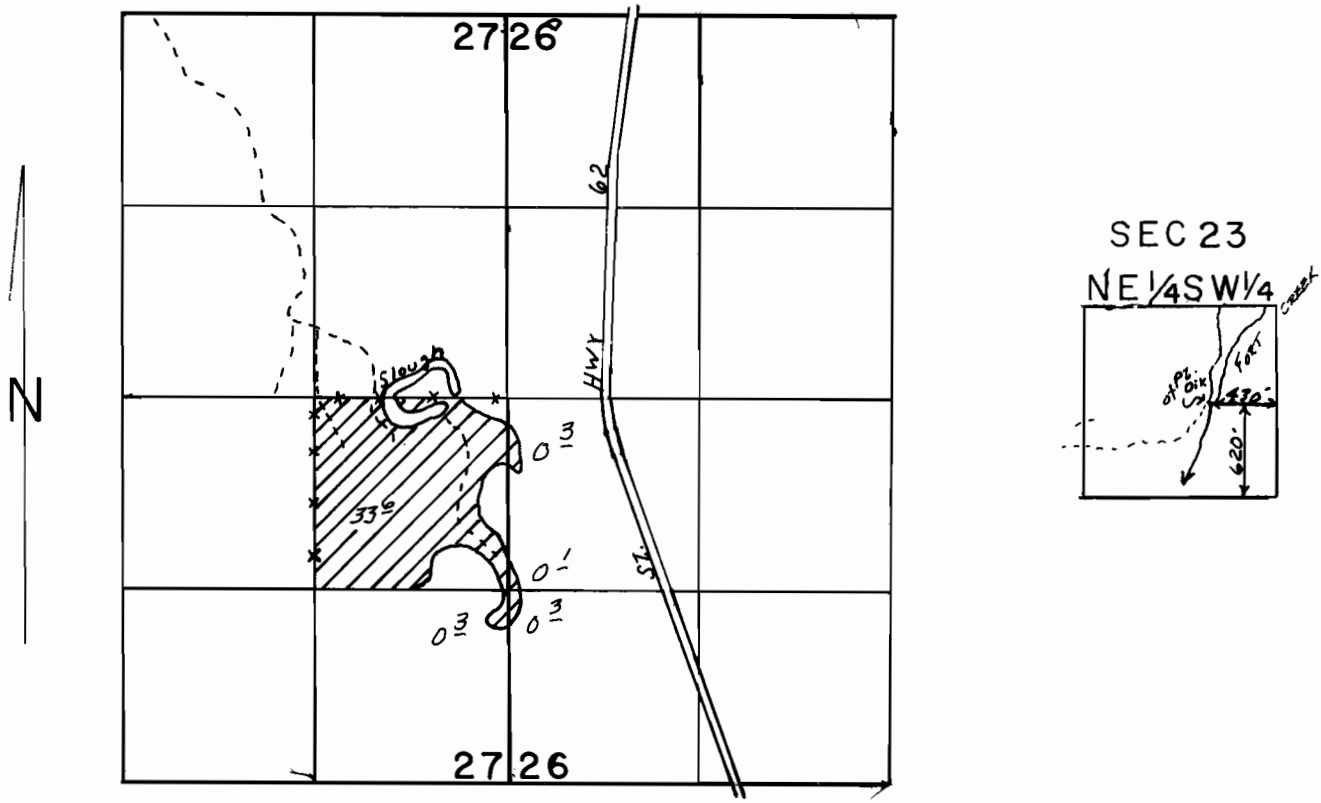

SCALE: 1" = 1320'

**FINAL PROOF SURVEY**  
UNDER

Application No. ~~56074~~ Permit No. ~~42882~~....  
**IN NAME OF**  
James Grimes, Hetta Maurine Grimes  
..... Emma M. Davis .....

Surveyed *Nov. 13.* 19*91.*, by *D. Sparks*.....