


T.34S., R.7E., W.M.

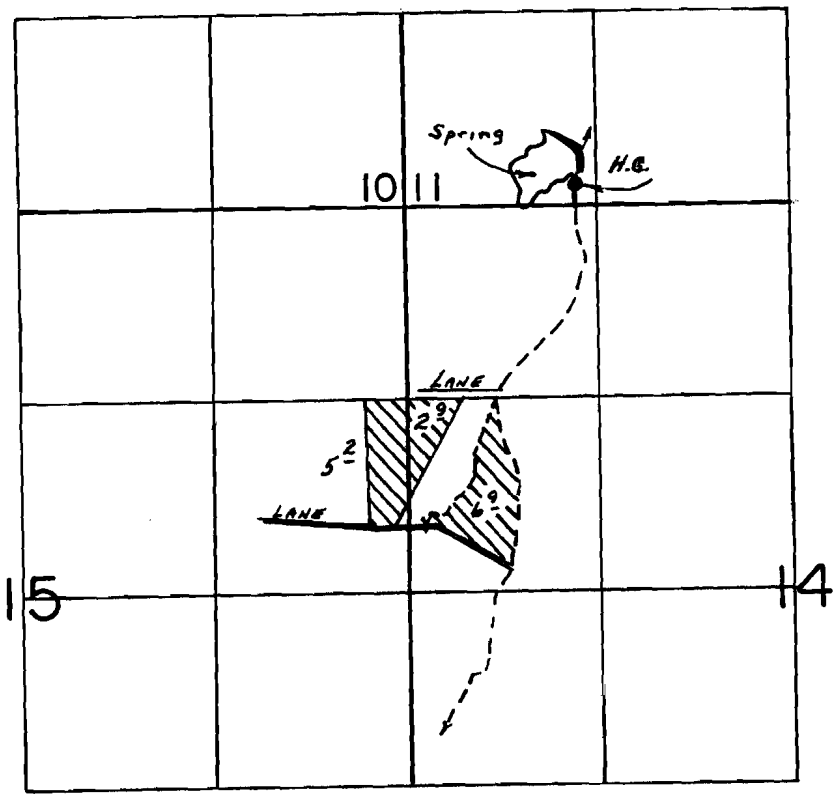


Div. Pt. Loc: 350' N & 1200' E. FROM SW Cor. SEC. 11

SCALE: 1" = 1320'

**FINAL PROOF SURVEY
UNDER**

Application No. ~~56969~~ Permit No. ~~42887~~....
IN NAME OF

.....JOHN ROBERT BRIGGS JR.

Surveyed Sept. 11... 1986, by B.W. BISHOP....