


T. 26 S., R. 12 W., W.M.

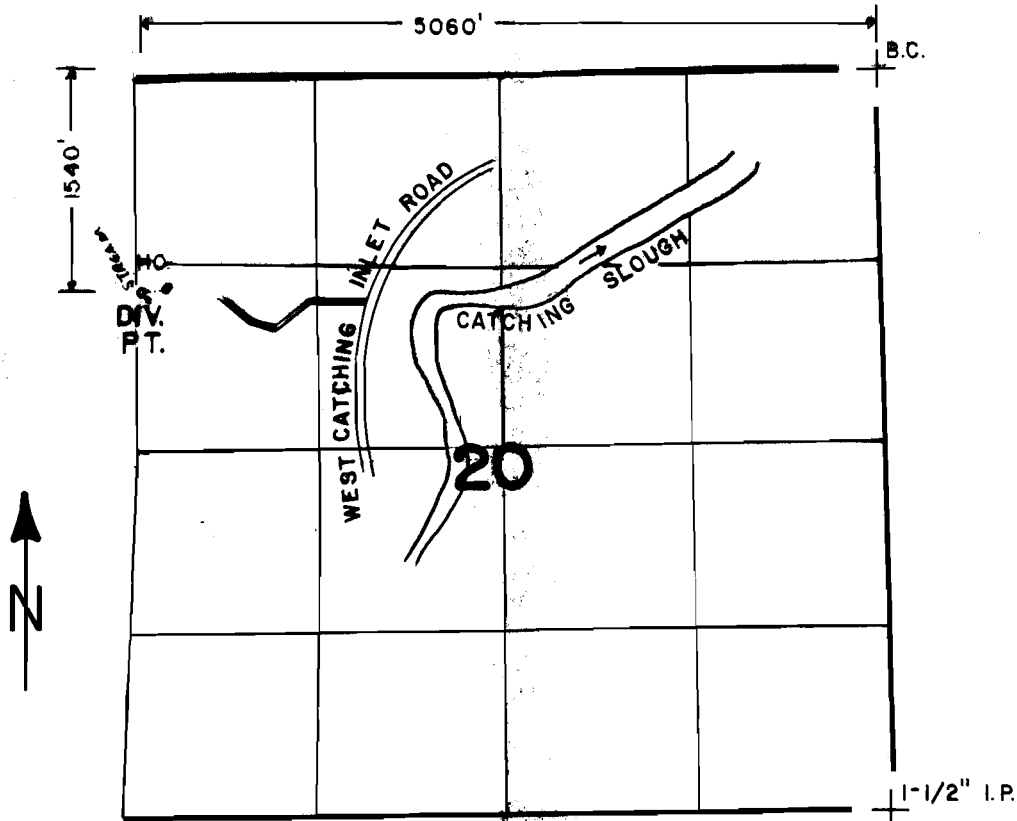

SCALE: 4" = 1 MILE

FINAL PROOF SURVEY
UNDER

Application No. 56931 Permit No. 42828
IN NAME OF

JOHNIE S. ADDISON

Surveyed OCT. 26, 1983, by L. E. CASHION