


T. 24 S., R. 5 W., W.M.

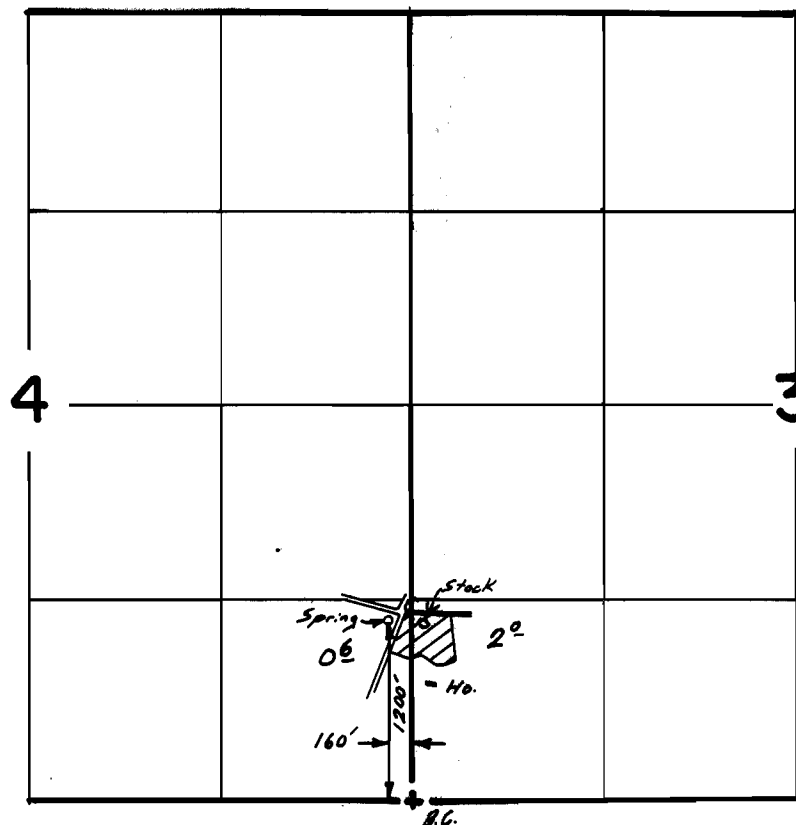

Scale 1"=1320'

**FINAL PROOF SURVEY
UNDER**

Application No. ~~56932~~ Permit No. ~~42959~~....
IN NAME OF

.....BILLIE RUTH BARRON.....

Surveyed Sept. 11, 1991, by S. James & L. Joachims