

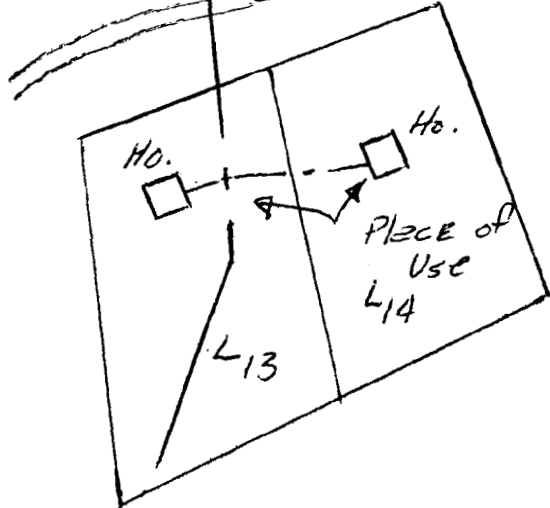
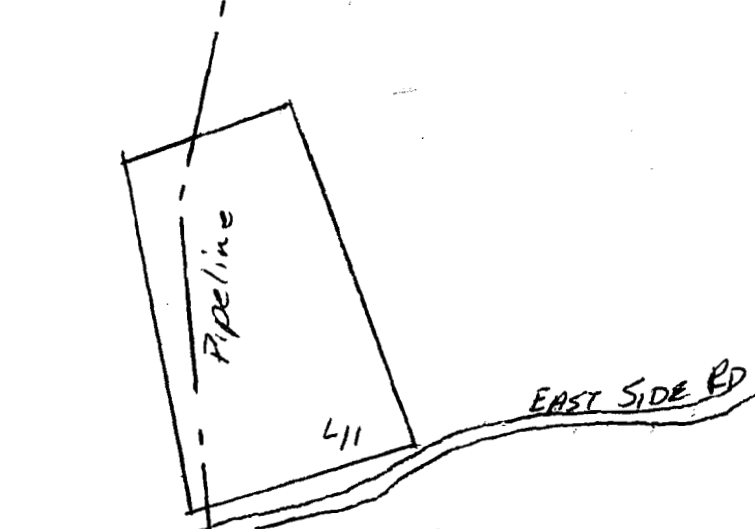
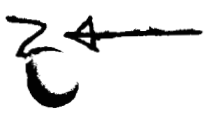


43335
68027

RECEIVED
MAY 30 1978
WATER RESOURCES DEPT.
SALEM, OREGON

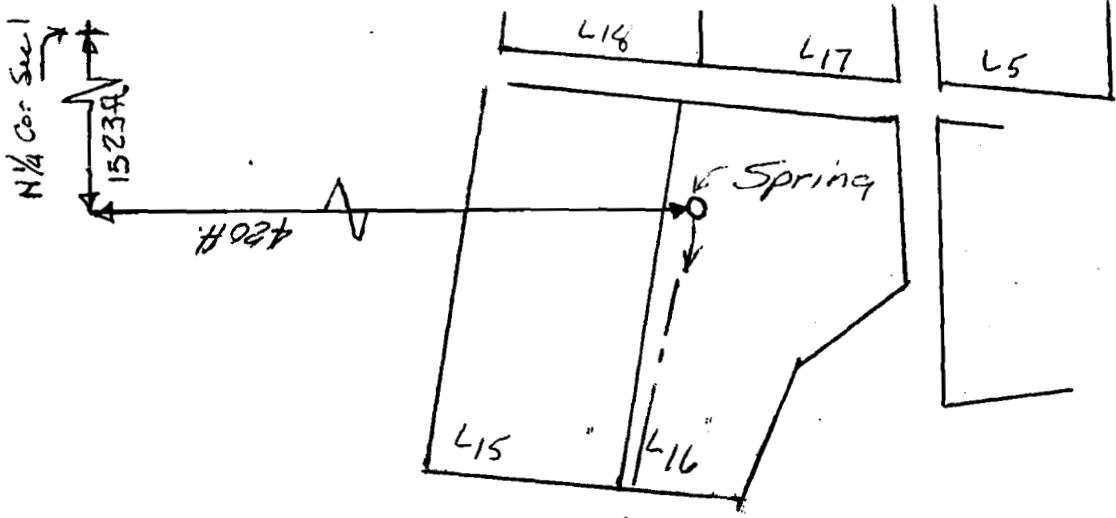

Application Map
for
FRANK P. DREW

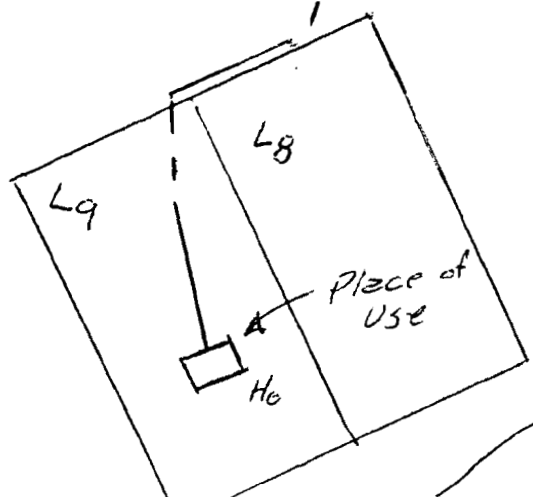

DC Brown

LAKE OF THE
WOODS

Application No. 57464
Permit No. 43335
Fournelle Creek & Misc.