


T. 31 S., R. 2 W., W. M.

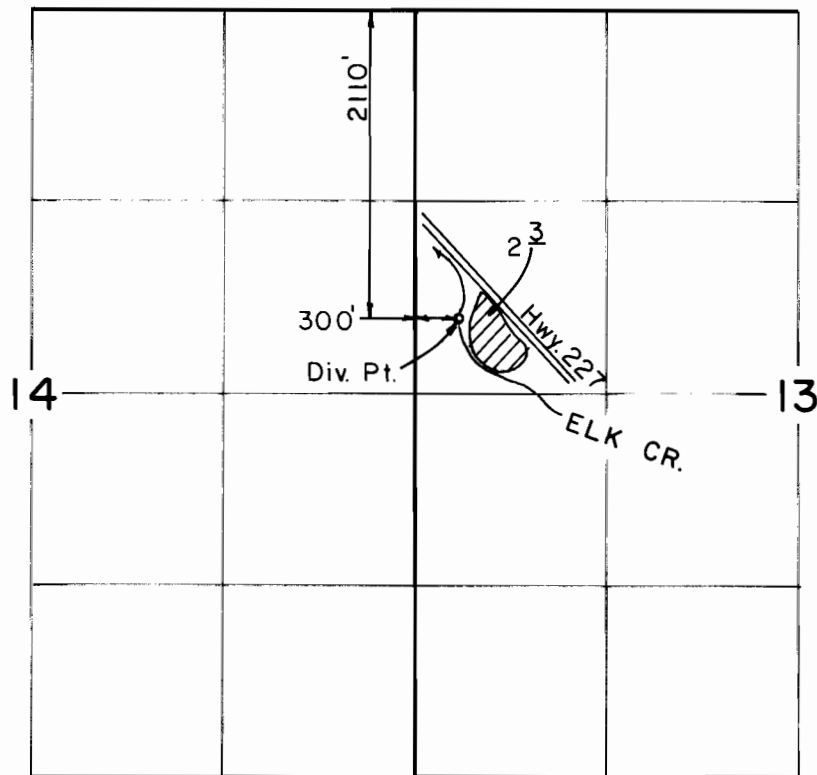

Scale: 1" = 1320'

# FINAL PROOF SURVEY UNDER

Application No. 57498 Permit No. 43278...  
IN NAME OF

.....BILL B. ANDERSON.....

Surveyed JULY 29 1991., by B. S. JAMES....