


T. 40 S., R. 2 W., W. M.

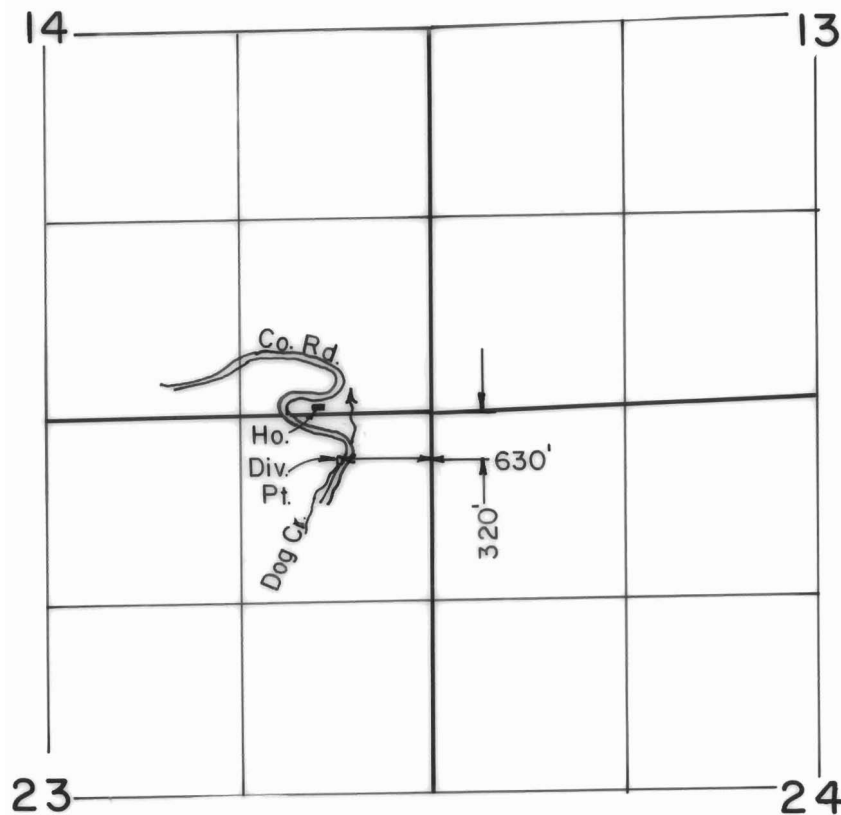

Scale: 1" = 1320'

FINAL PROOF SURVEY UNDER

Application No. 59526. Permit No. 44979....
IN NAME OF

.....VIRGINIA.....GOETTINA.....

Surveyed AUG. J... 1991., by B. S. JAMES...