


T. 33 S., R. 1 W., W. M.

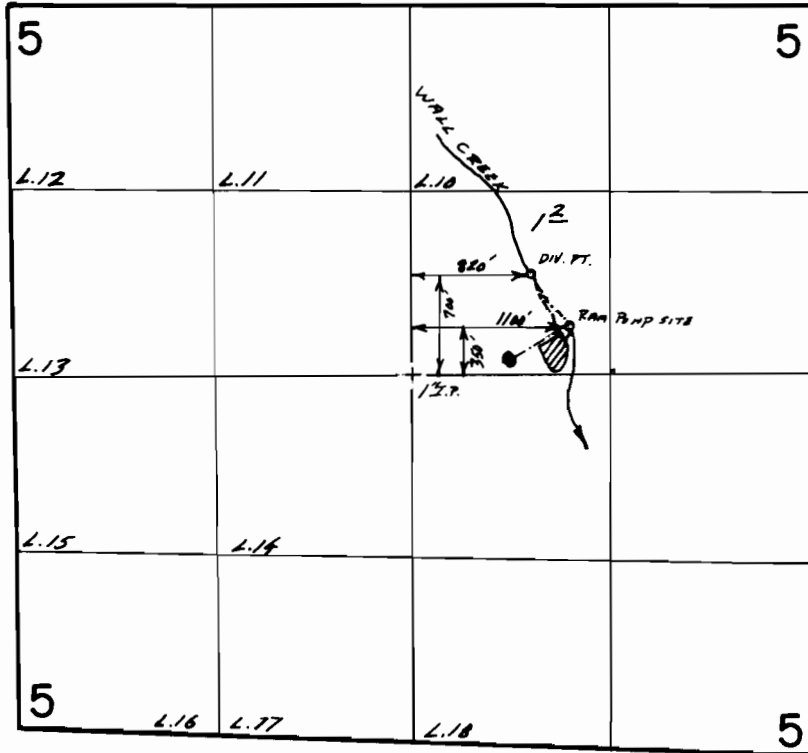

Scale 1"=1320'

FINAL PROOF SURVEY
UNDER

Application No. 5969! Permit No. 45303.....
IN NAME OF

.....THUNDER..... RIVER..... CORP.....

Surveyed July 29, 199!., by S. James.....