T. 28S., R. 7 W., W. M.

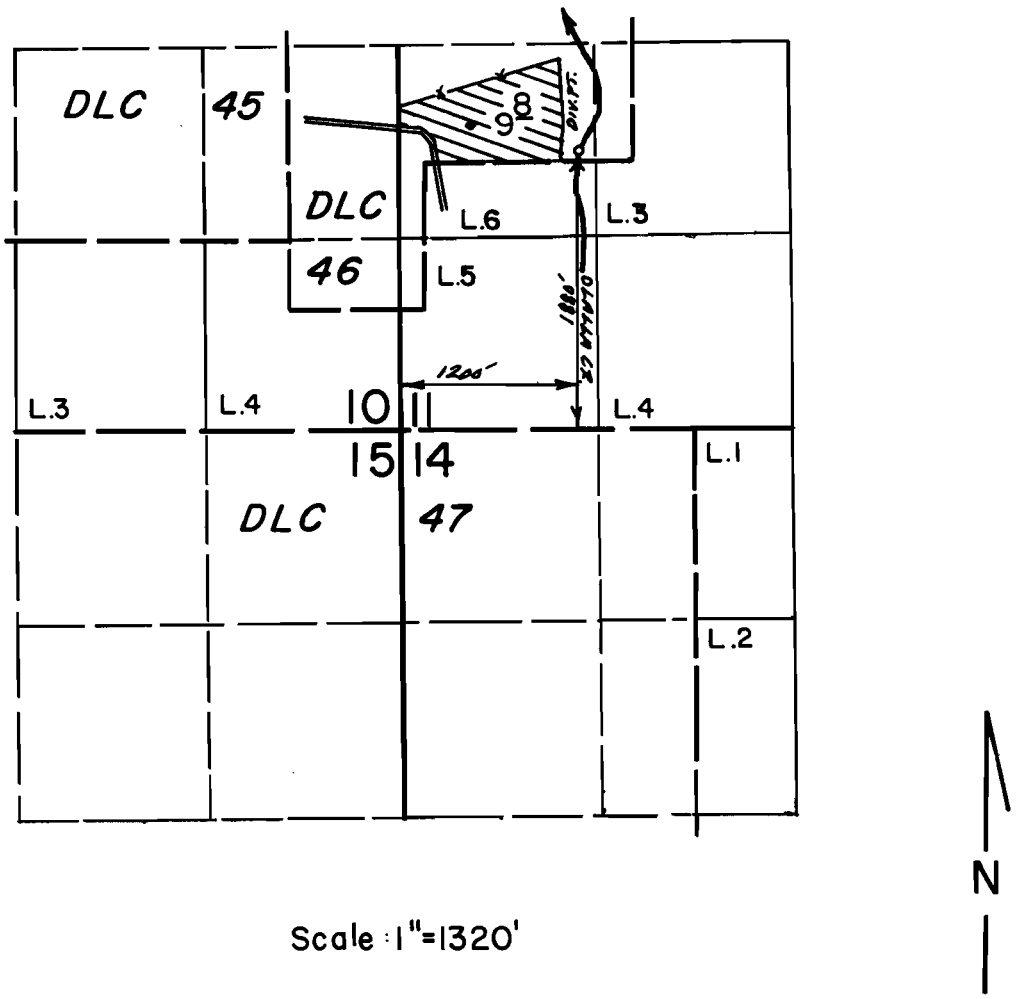

Scale: 1"=1320'

FINAL PROOF SURVEY
UNDER

Application No. 59703 **Permit No.** 45244
IN NAME OF

WELDON T. & BETTY S. HEARD

Surveyed May 13, 1987, **by** J.M. Schmorde

BTR-244-147

4