


T. 38 S., R. 3 W., W. M.

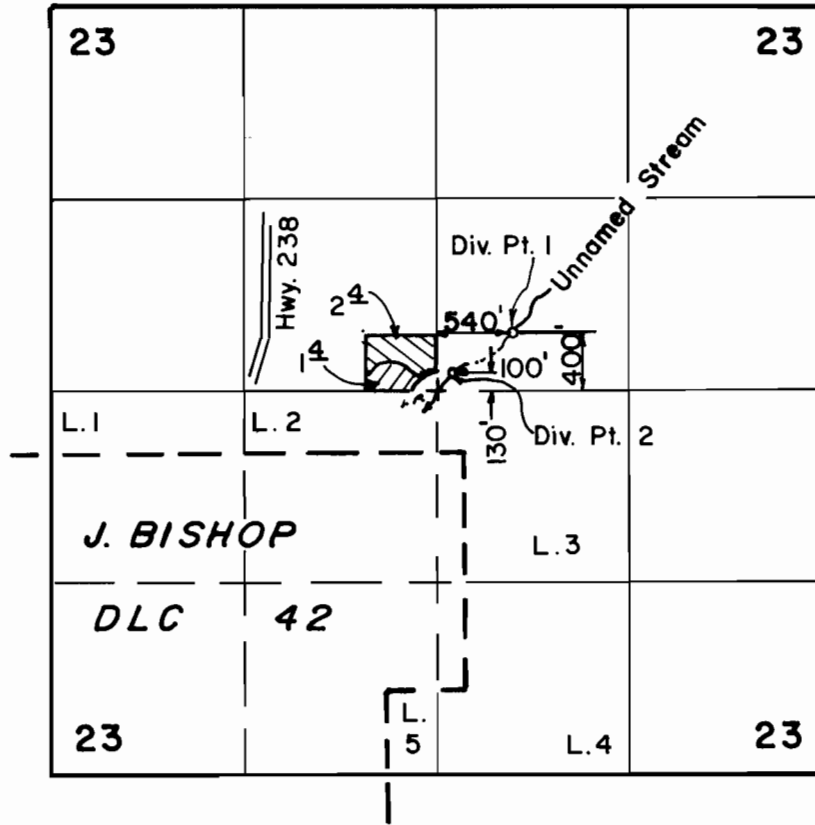

Scale: 1" = 1320'

Div. Pt. 1

Div. Pt. 2

**FINAL PROOF SURVEY
UNDER**

Application No. 59880. Permit No. 45227...
IN NAME OF

ADA & RAYMOND ROBERTSON

Surveyed OCT. 24. 1991., by L.M. JOACHIMS