


T.26S., R.5W., W.M.

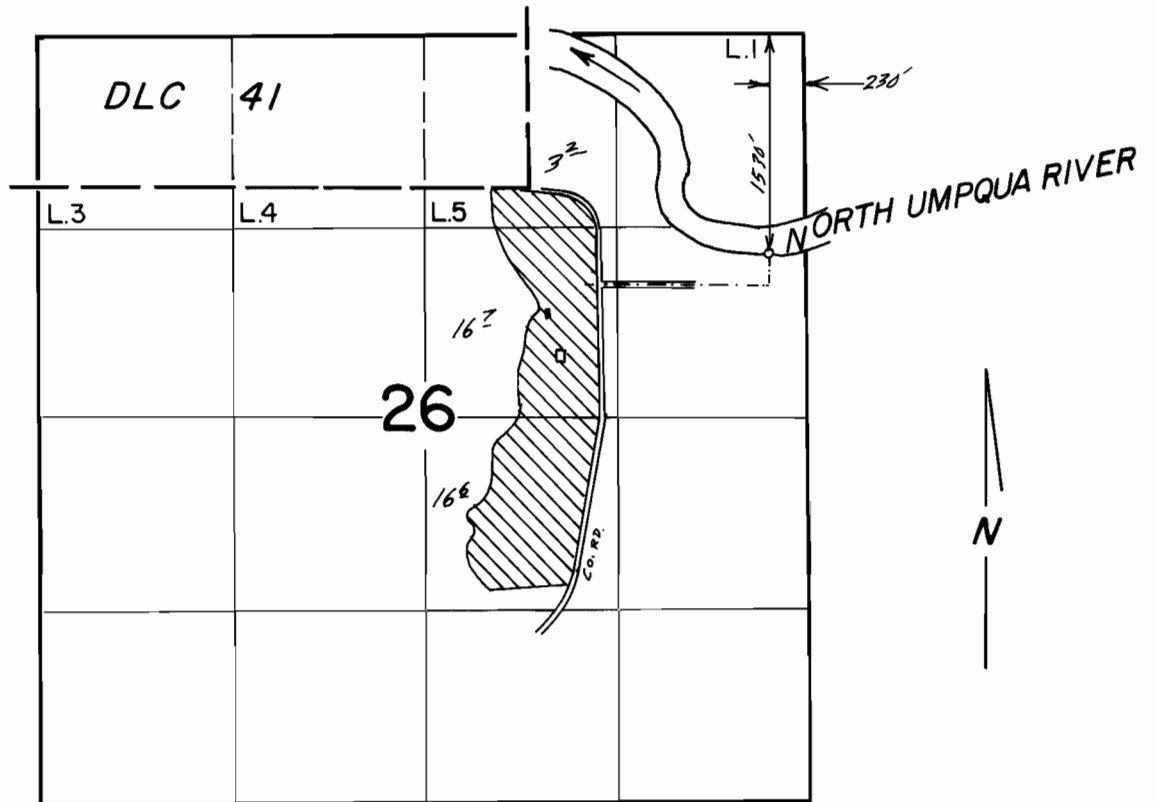

Scale 1"=1320'

**FINAL PROOF SURVEY**  
**UNDER**

Application No. 62378 Permit No. 46945....  
**IN NAME OF**

.....ANDREW F. KAHN.....

Surveyed Aug. 7, 1991, by B.S. James.....