


T. 33 & 34 S., R. 1 W., W.M.

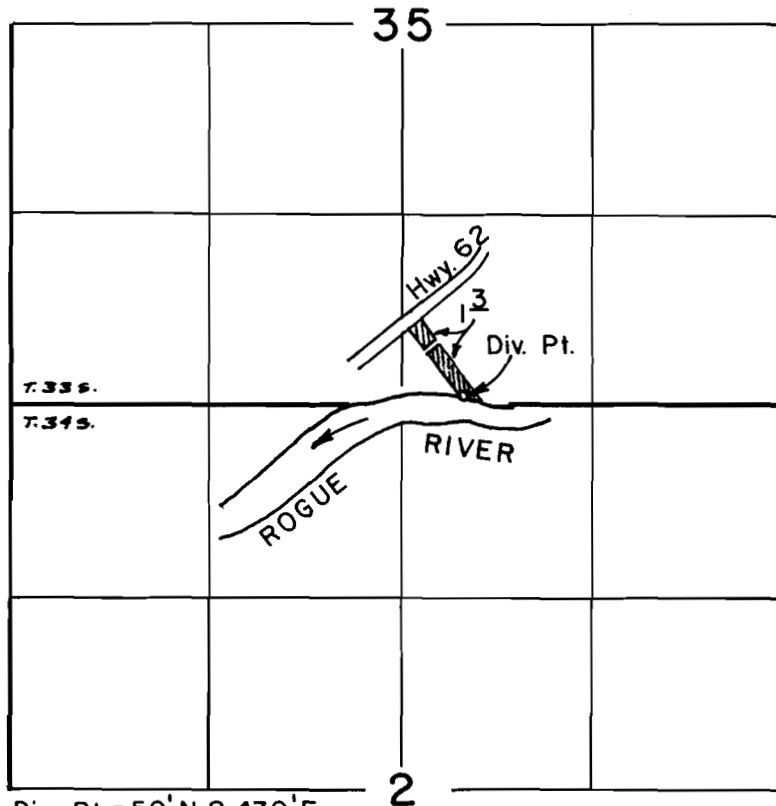

Div. Pt. = 50' N & 430' E
from S1/4 cor. Sec. 35

Scale: 1" = 1320'

FINAL PROOF SURVEY
UNDER

Application No. 62908 Permit No. 47074...
IN NAME OF

LOUIS E. & CLARA F. ARNOLD...

Surveyed JULY 2, 1991., by B. S. JAMES...