


T. 25 S., R. 4 W., W. M.

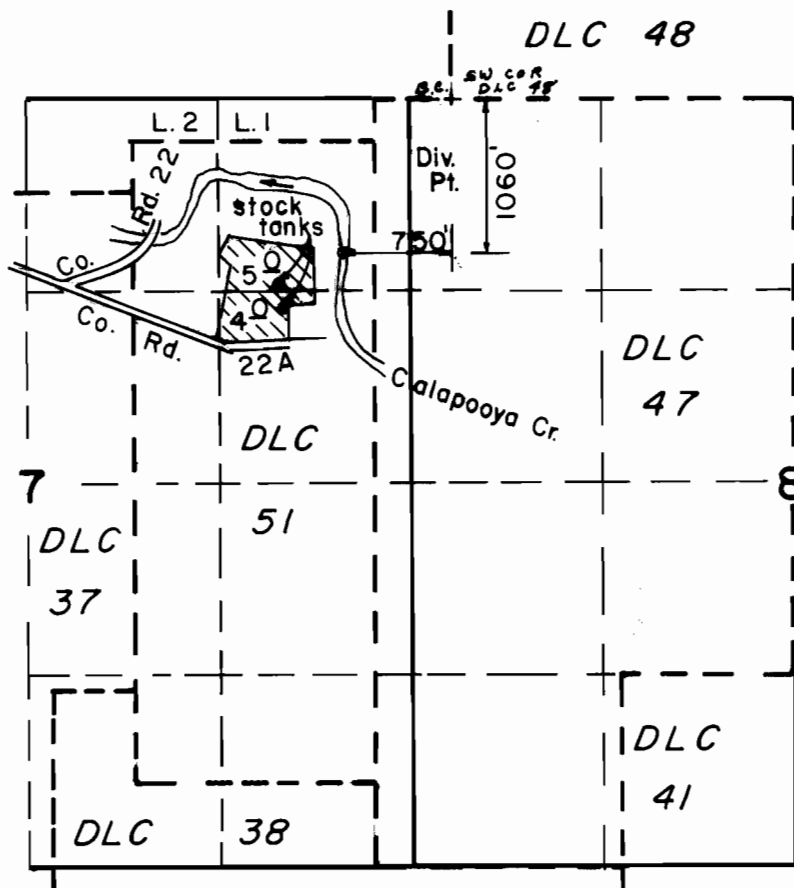

Scale: 1" = 1320'

FINAL PROOF SURVEY
UNDER

Application No. 63577 Permit No. 47207
IN NAME OF

BILL M. LYNN

Surveyed AUG...8. 1990, by B...S...JAMES...