


T. 38 S., R. 3 W., W. M.

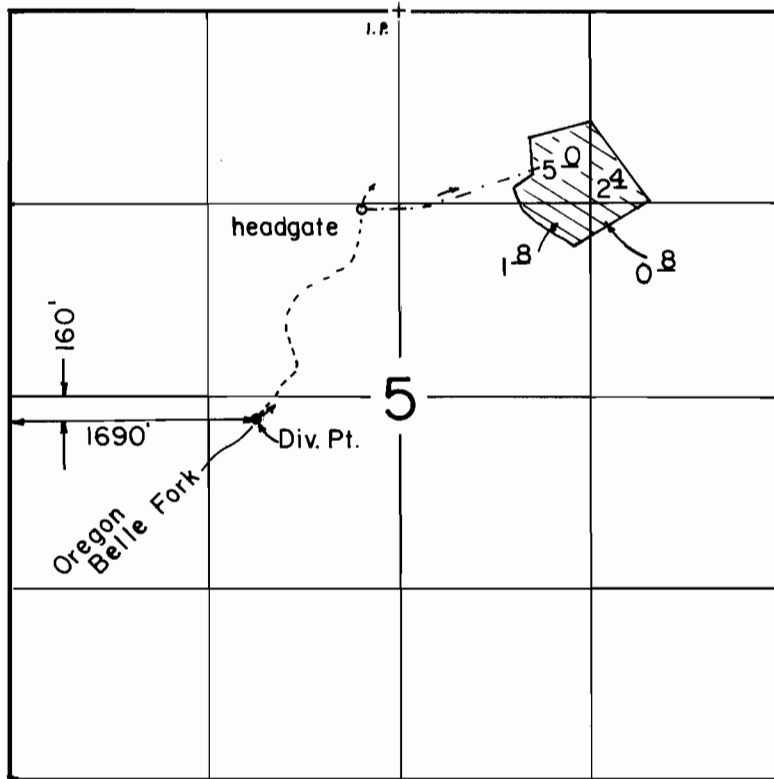

Scale: 1" = 1320'

**FINAL PROOF SURVEY  
UNDER**

Application No. 64418. Permit No. 47141....  
IN NAME OF

JOHN...M...&...MARGUERITE...BLACK

Surveyed OCT. 15. 1991., by B. S. JAMES...