


T.27S., R.6W., W.M.

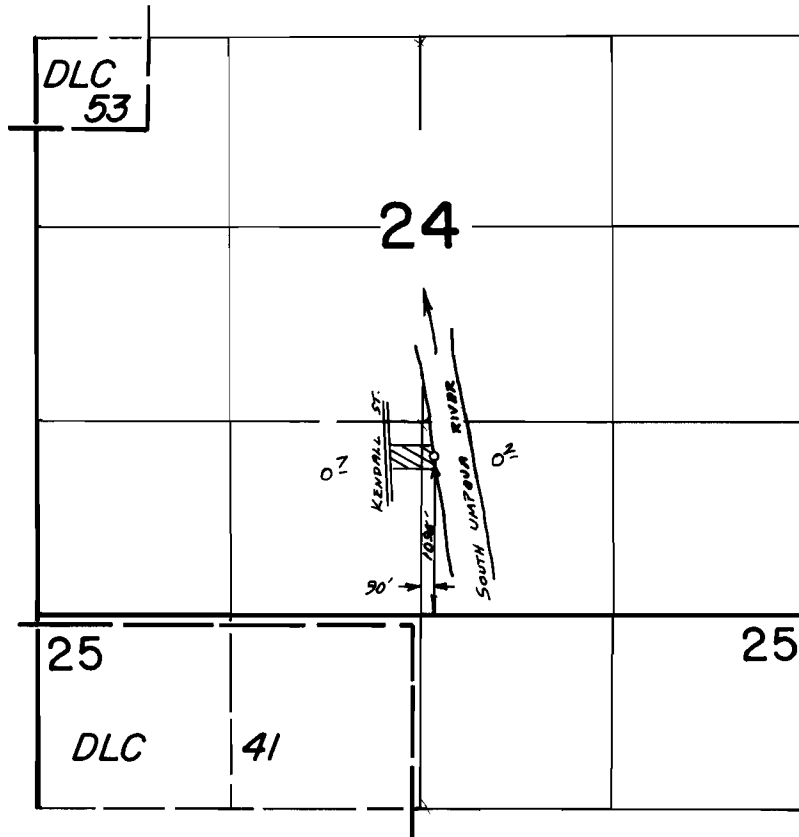

Scale 1" = 1320'

**FINAL PROOF SURVEY**  
UNDER

Application No. 65710. Permit No. 48010....  
IN NAME OF

.....*ROBERT A. & GLORIA S. DRIVER*.....

Surveyed Oct...7.. 1986., by J.R. Kauppila...