
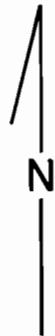


T. 33 & 34 S., R. 1 W., W. M.

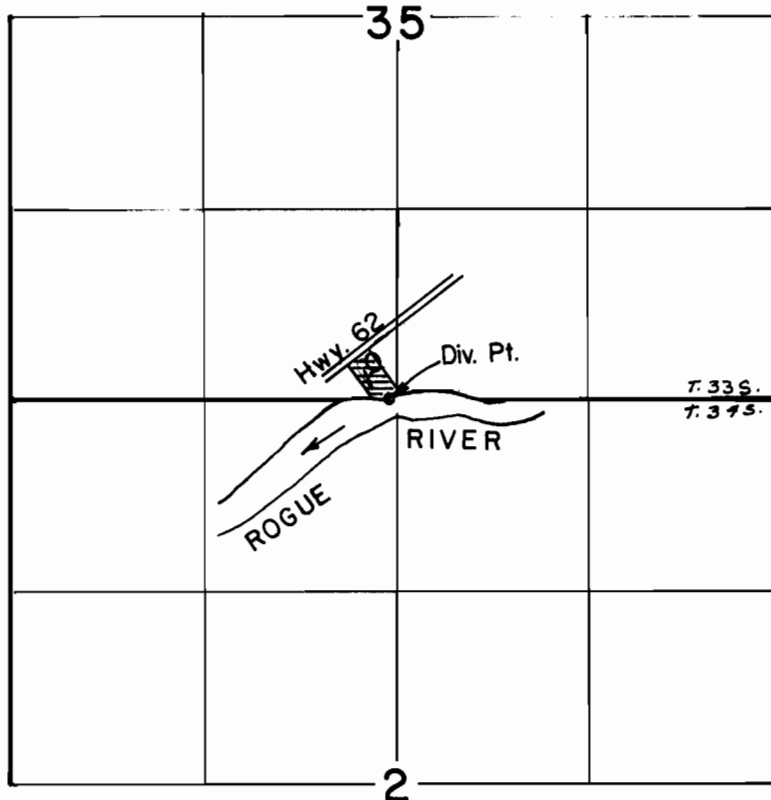

Div. Pt.: 50' W. from the  
N. 1/4 corner of  
Sec. 2

Scale: 1" = 1320'

### FINAL PROOF SURVEY UNDER

Application No. 68777 Permit No. 49892....  
IN NAME OF

.....FRED J. DUERST.....

Surveyed SEPT. 5. 1991., by B. S. JAMES...