


T. 26 S., R. 6 W., W. M.

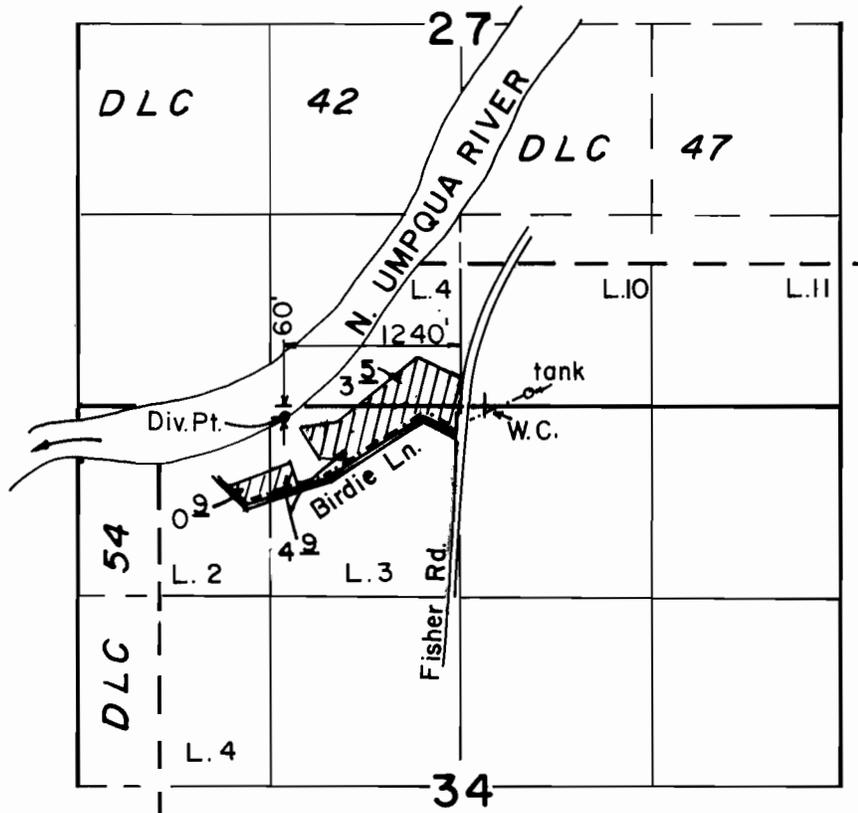

Scale: 1" = 1320'

**FINAL PROOF SURVEY
UNDER**

Application No. 68809 Permit No. 49904...
IN NAME OF

.....JOHN H. MARKHAM, JR.....

Surveyed OCT. 23. 1990, by L. JOACHIMS....