


T. 29 S., R. 5 W., W.M.

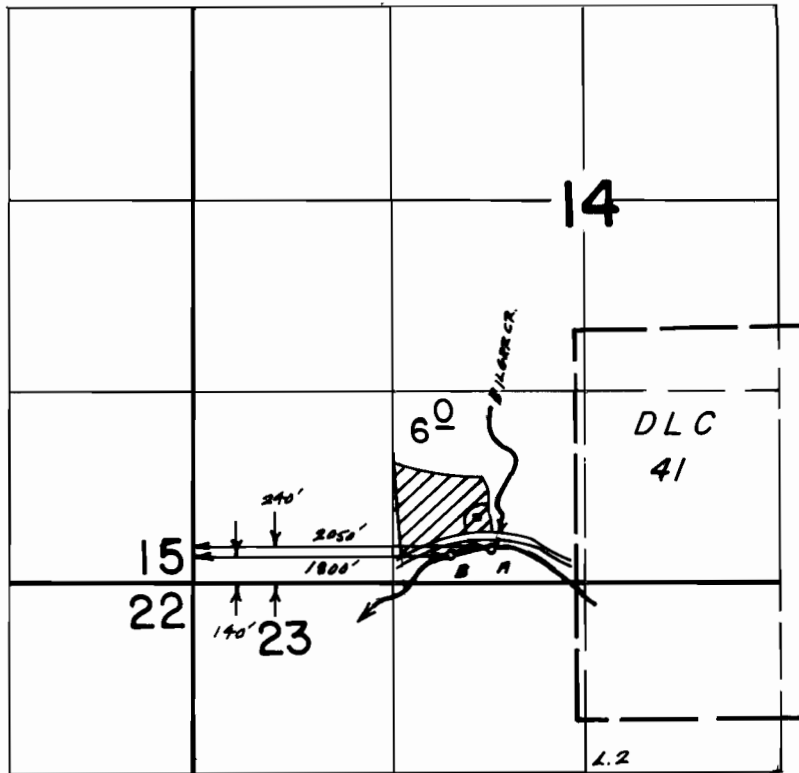

Scale 1"=1320'

**FINAL PROOF SURVEY
UNDER**

Application No. 68835 Permit No. 49867...
IN NAME OF

MELVIN W. & M. JEAN BLACK

Surveyed March 13, 1990, by B.S. James.....