


T. 35 S., R. 12 W., W.M.

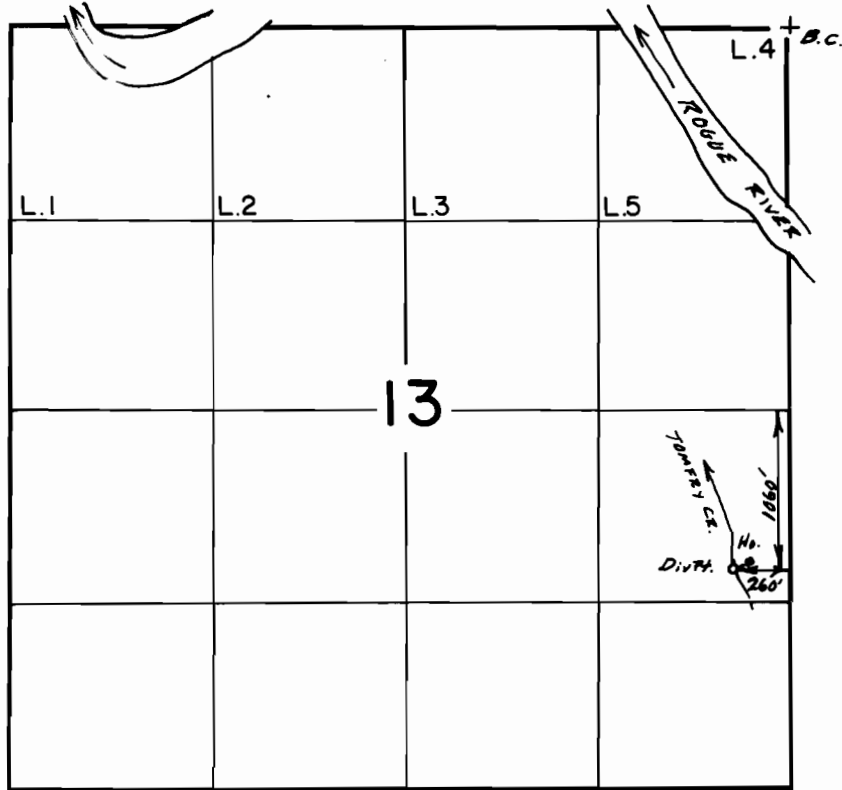

Scale 1"=1320'

FINAL PROOF SURVEY
UNDER

Application No. 69077 Permit No. 50035....
IN NAME OF

DALLAS V. & MERRY J. COLVIN

Surveyed July 30, 1989, by B.S. JAMES....