


JUD 77
68045

Fourmile Creek & Mac.

T. 37 S., R. 5E. W.M.

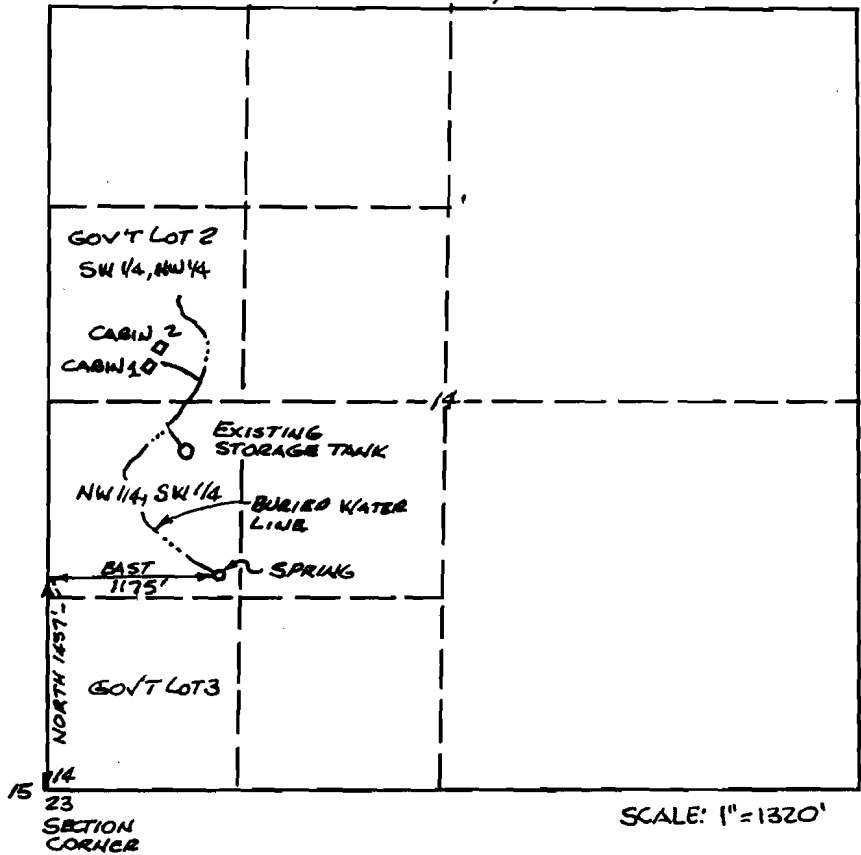

FINAL PROOF MAP


UNDER

APPLICATION NO 69561 PERMIT NO. _____

IN NAME OF

CLIFFORD B. HALBERT

EXAMINED JULY 3, 1989 BY LARRY J. FRIAR CWRE 49

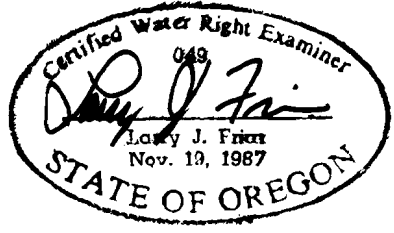

THE PREPARATION OF THIS MAP WAS FOR THE PURPOSE OF IDENTIFYING THE WATER RIGHT ONLY & HAS NO INTENT TO PROVIDE DIMENSION OR LOCATION OF PROPERTY OWNERSHIP LINES.