


T. 26 S., R. 5 W., W.M.

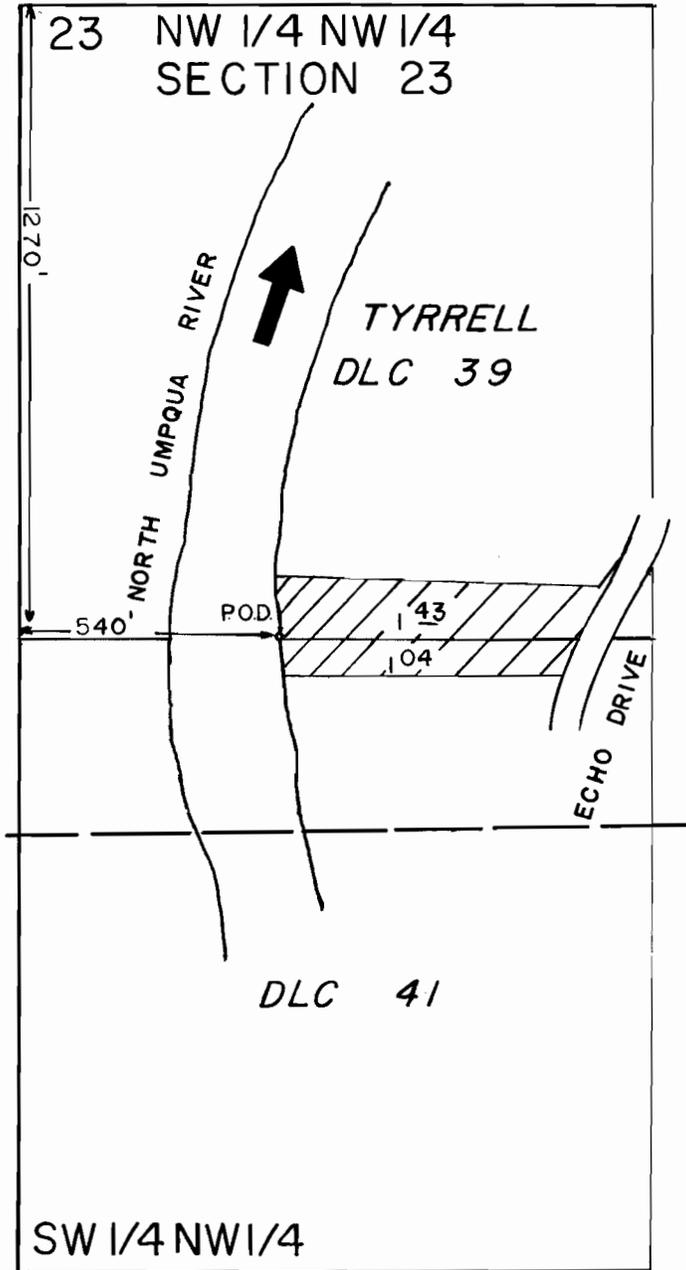

THIS MAP IS FOR THE PURPOSE OF IDENTIFYING THE LOCATION OF THE WATER RIGHT ONLY AND IS NOT INTENDED TO PROVIDE LEGAL DIMENSIONS OR LOCATION OF PROPERTY OWNERSHIP LINES.

[Handwritten Signature]

FINAL PROOF SURVEY
UNDER

Application No. 70505. Permit No. 51101.....

↓ . . . IN NAME OF
DAN & PAULA RINNERT

Surveyed **Sept. 10 1992.**, by **S. James**.....

