


G5470
T 6016
69051

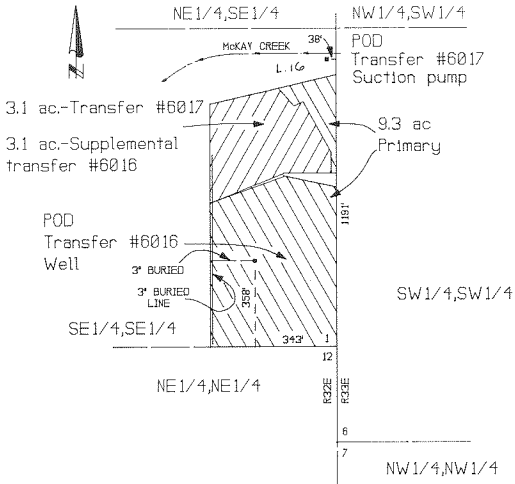


Preparation of this map is for the purposes of water right location only. Any references to survey lines are for informational purposes only, and are not actual surveyed property lines.

K	KRUMBEIN ENGINEERING LTD. ENGINEERS — SURVEYORS — PLANNERS 361 S.E. Second Pendleton, Oregon	Scale 1"=100'	Drn. By M,JP	Drng. No. 98-18A	Revision 1
		Date 5-15-98	Ckd. By DHR	Job No. 98-27	Revision 2

Final proof survey for

FARIS

SE1/4,SE1/4,Sec.1,T1S,R32E,W.M.

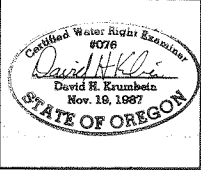

98-18A

98-27