


G-6362
68057

T.39S.,R.13E.,W.M.

Miller Creek Wells

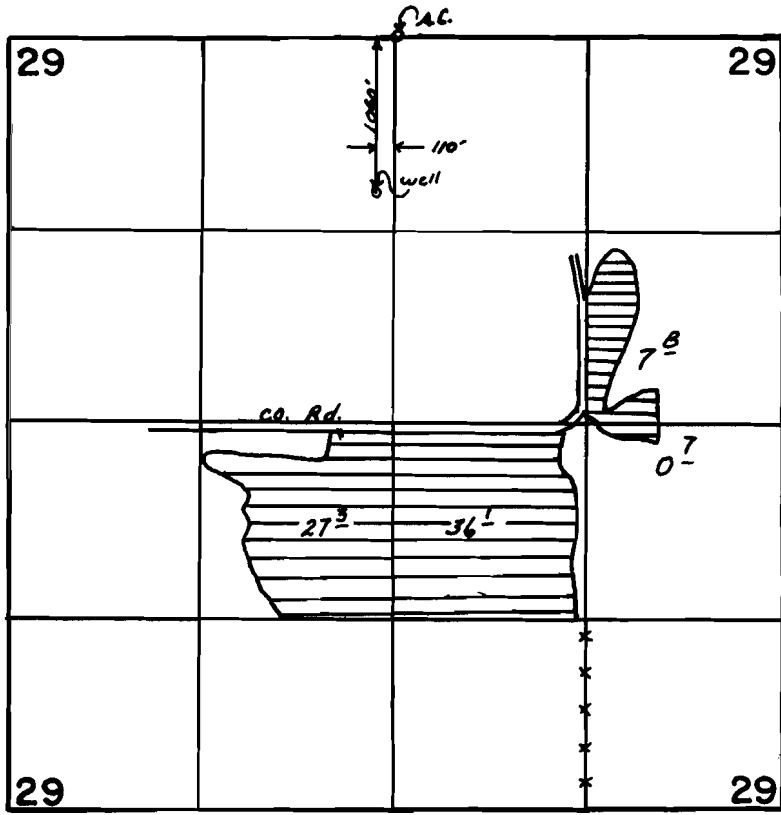

SCALE: 1" = 1320'

FINAL PROOF SURVEY UNDER

Application No. G-7235 Permit No. G-6362....
IN NAME OF

.....G. ROGER & KAREN S. HAMILTON.....

Surveyed *Nov. 9.* 19*91.*, by *D. Sparks*.....