



T.7S., R.2W., W.M.

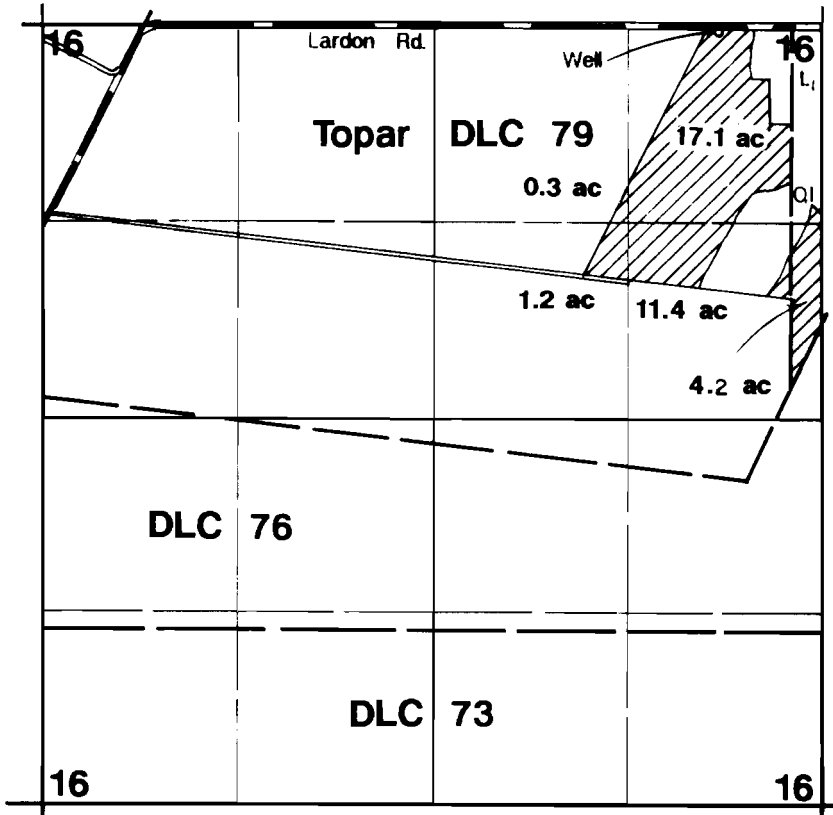

Area Irrigated

Well located 30'S & 673'W from NE corner Section 16.

Final Proof Survey

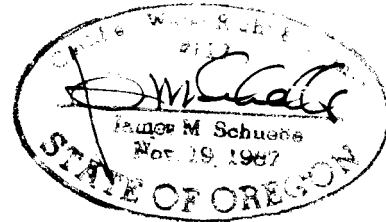

Application #G-11798 Permit #G-10917

In Name Of

Raymond J. Satter

Surveyed on June 30, 1990 by JM Schuette

NOTE: Map is for purpose of identifying location of water right and has no intent to dimension or locate property ownership lines.