


T. 5 S. R. 34 E. W.M.

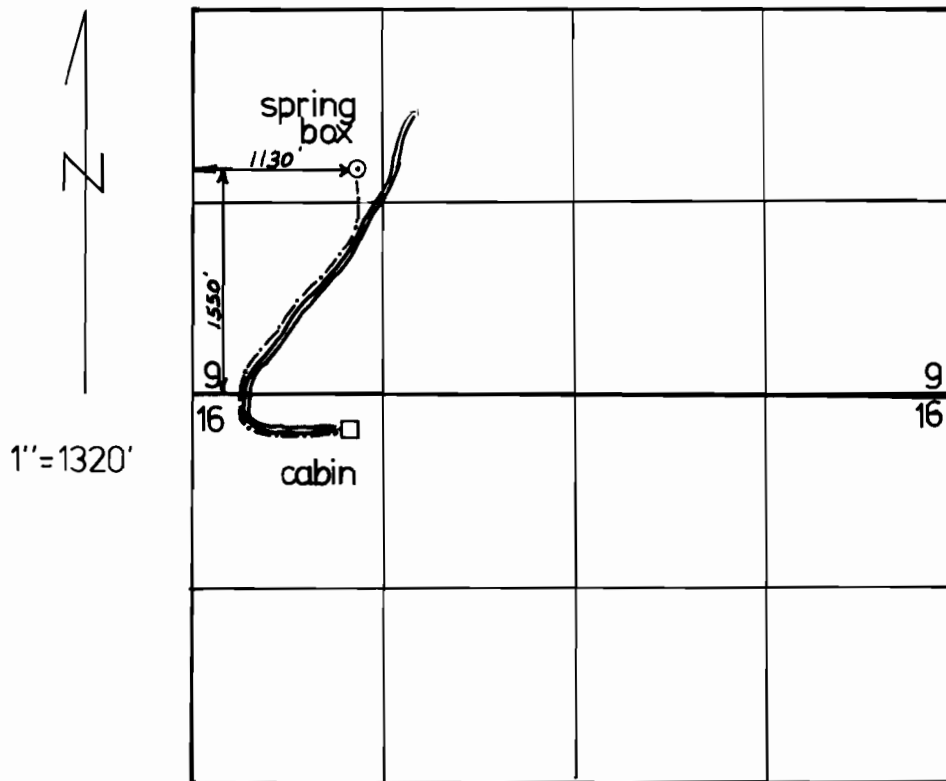

FINAL PROOF SURVEY UNDER

Application No. **52529** Permit No. **37.801..**
IN NAME OF

DONALD D. SMITH M.D. & MARY B. SMITH
RUTH ANN BISSINGER
Surveyed 8-29-1991, by J. MILLER.....