


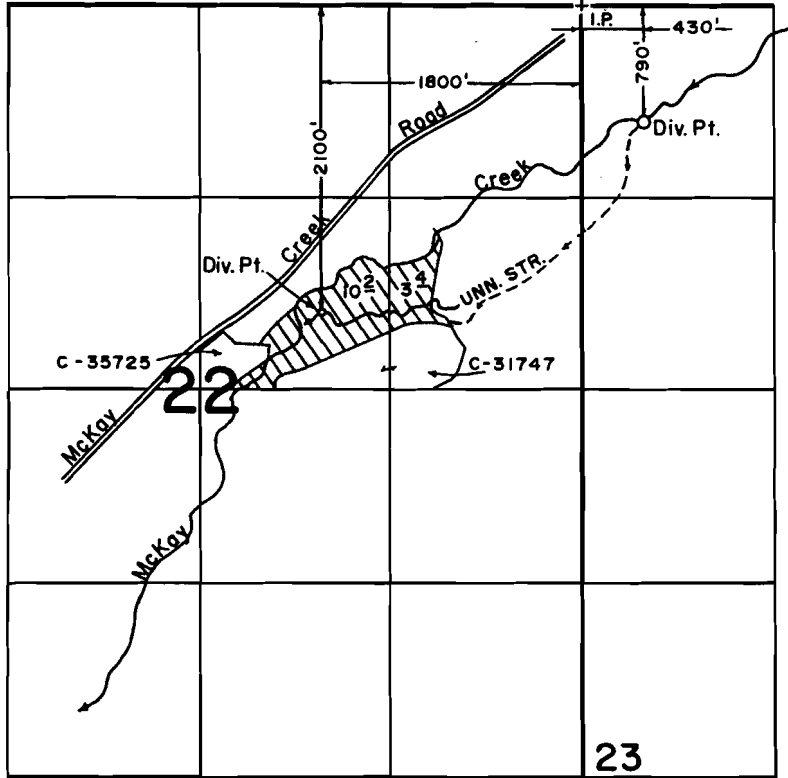

T. 13 S., R. 16 E., W.M.



SCALE: 1" = 1320'

FINAL PROOF SURVEY
UNDER

Application No. 53500.. Permit No. 40048....
IN NAME OF

.....**ROBERT J. MILLER**.....

Surveyed DEC. 27.. 1989., by ..B. W. BISHOP.....

Cont. 68060

1-31-90
41013-180-1360

40048

RECEIVED MAR 0 5 1993