69061

T.36S., R.10E., W.M.

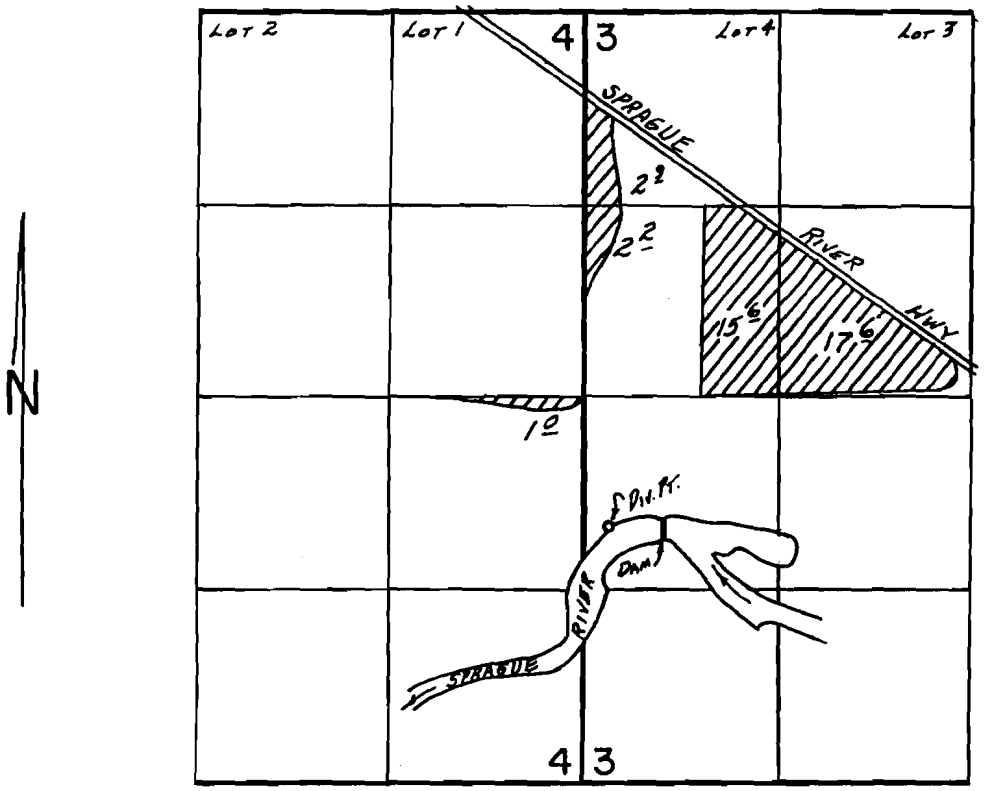

DIV. PT. LOC.: 870'S. & 200'E. FROM W 1/4 COR. SEC. 3

SCALE: 1" = 1320'

FINAL PROOF SURVEY
UNDER

Application No. 54625 **Permit No.** 40987

IN NAME OF

BILL & ROSALYN HARRIS

Surveyed Apr. 17 **1991**, **by** R.W. BISHOP

41035-178-81C

1-9-92
BWD