


T. 2N. R. 48E., W.M.

N
↑
1" = 1320'

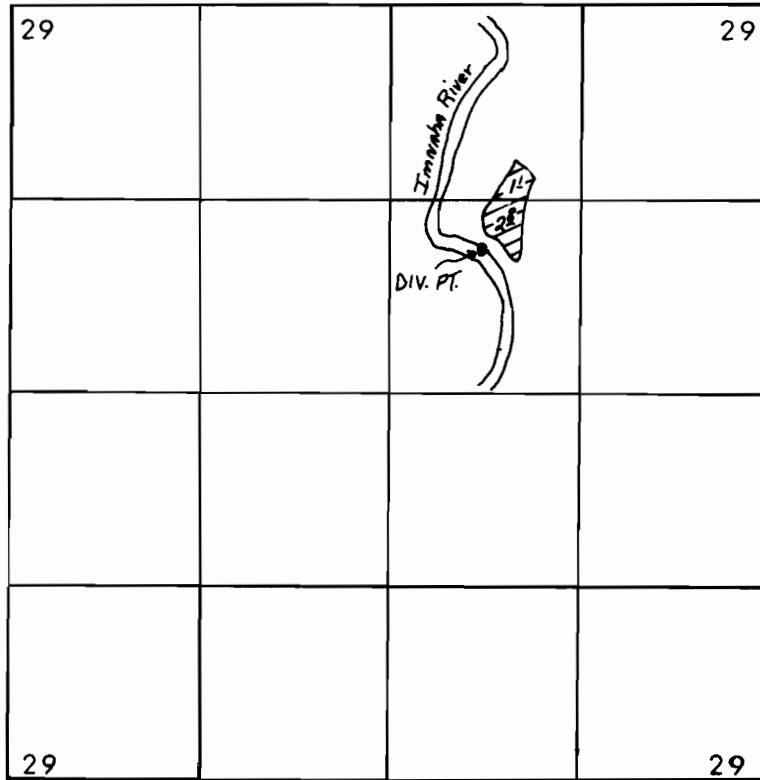

POD located 1680 feet South and 1980 feet West
from the NE Corner of Section 29.

FINAL PROOF SURVEY UNDER

Application No. 57335... Permit No. 43181.....
IN NAME OF

.....MARVIN MAXWELL.....

Surveyed 10-6..... 1990, by K.KEMP.....