


T. 4 S., R. 5 W., W.M.

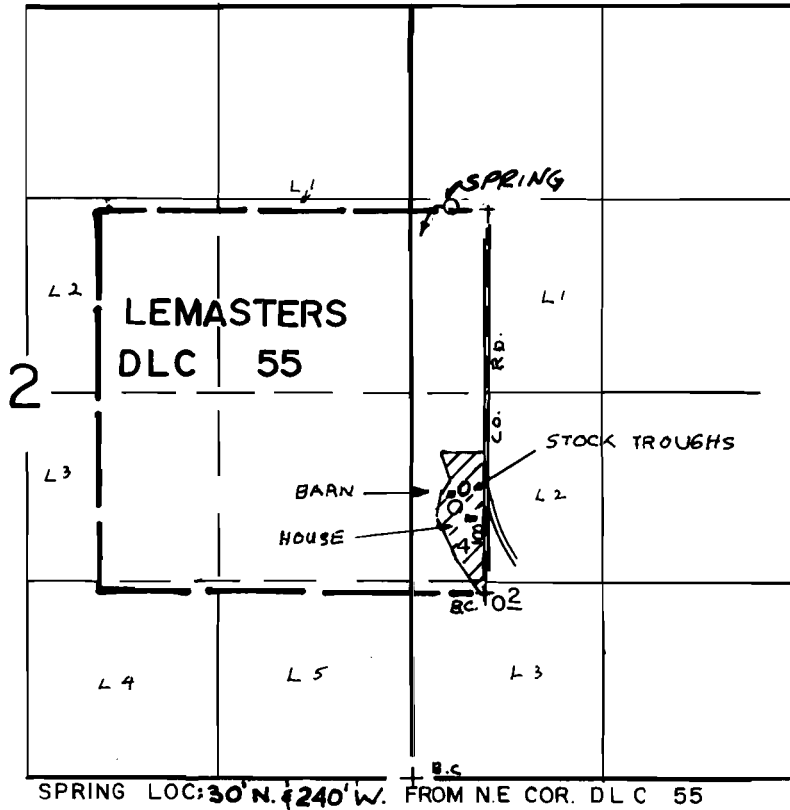

SCALE: 1" = 1320'

**FINAL PROOF SURVEY**  
UNDER

Application No. 60201.. Permit No. 45508.....  
IN NAME OF

.....ALBERT.....R.....ENGEN.....

Surveyed OCT. 7..... 1983., by P. PAGTER.....