


T.1S. R.19E. W.M.

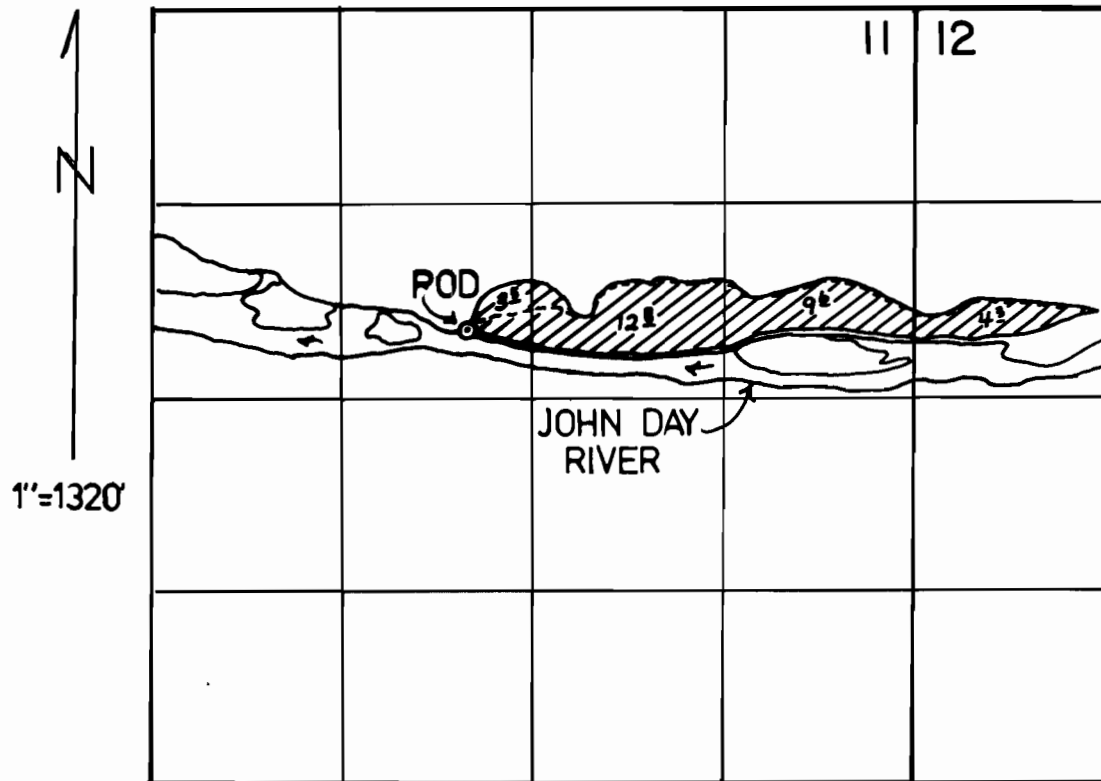

POD SE $\frac{1}{4}$ NW $\frac{1}{4}$ of Section 11, T. 1 S. R. 19 E.; W.M.
2200 feet South and 3010 feet West from the
Northeast Corner of Section 11.

FINAL PROOF SURVEY
UNDER

Application No. ~~64593~~ Permit No. ~~47319~~....
IN NAME OF

.....**ROBERT A. BOYNTON**.....

Surveyed ~~10-7~~ 19~~91~~, by ~~J. MILLER~~.....

Drafted
2-20-92
g. miller
IVCR