

RECEIVED

SEP 23 1983

ATER RESOURCES DEPT.
SALEM, OREGON

NOV 15 1983

WATER RESOURCES DEPT.
SALEM, OREGON

12501

Application No. R-66727
Permit No. R 9219

Reservoir is located in the NW 1/4 of NE 1/4 Sec 17 T150, R10E Hood River Co.

Approx 660' W. Sec 17
to 1/4 cor. Sec 8


RECEIVED

NOV 4 1983

WATER RESOURCES DEPT.
SALEM, OREGON

LEGAL DESCRIPTION

TOWNSHIP 1 SOUTH, RANGE 10 EAST, SECTION 17, TAX LOT 220, 14.48 ACRES HOOD COUNTY, OREGON

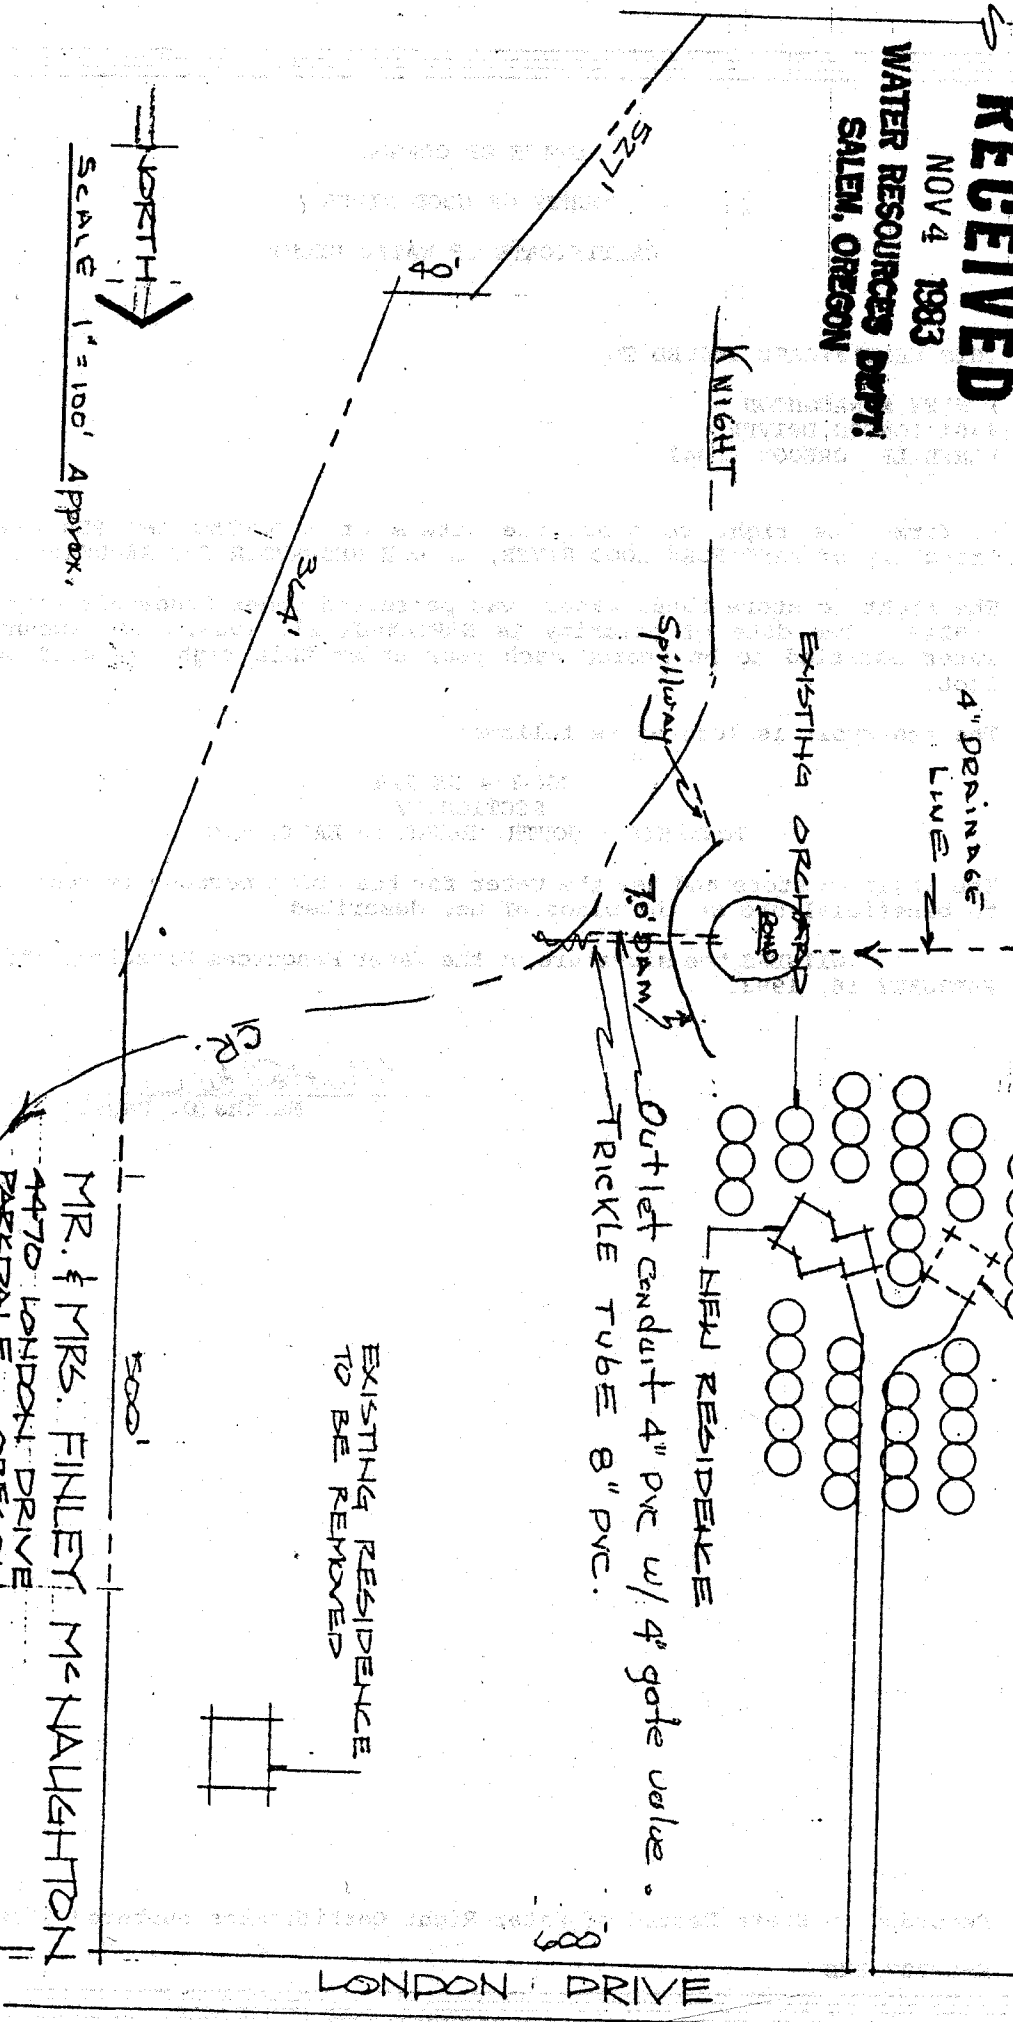

SCALE 1" = 100' Approx.



MR. & MRS. FINLEY McNAUGHTON
4470 LONDON DRIVE
PARDALE, OREGON
RESIDENCE SITE PLAN

LONDON DRIVE