


T. 26 S., R. 13 W., W. M.

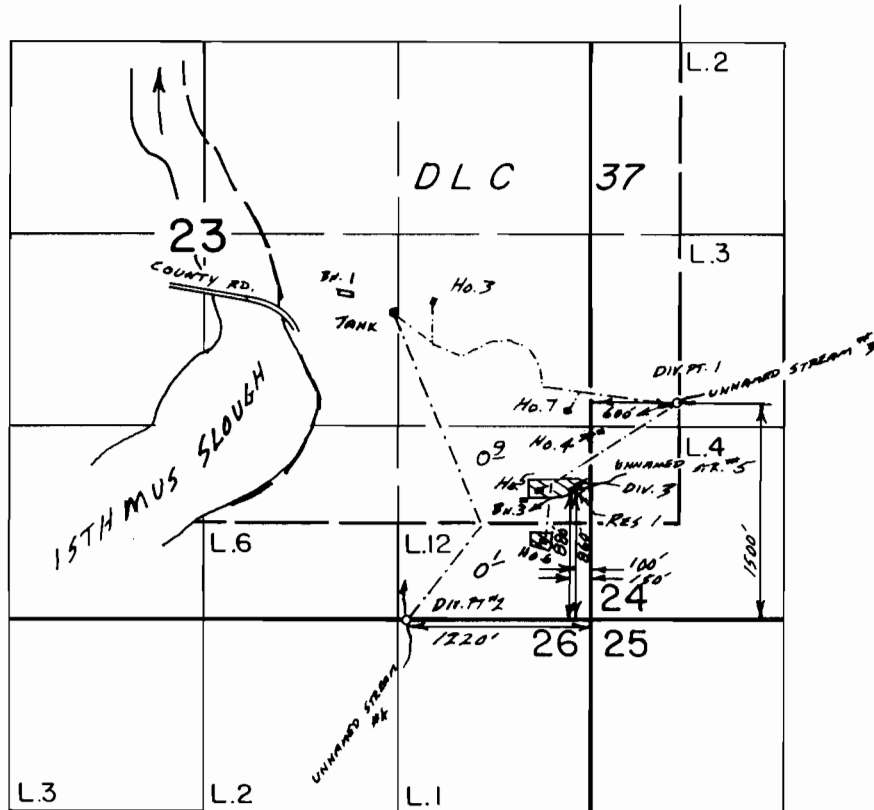

Scale : 1" = 1320'

**FINAL PROOF SURVEY**  
UNDER

R-69035                      R-10827  
Application No. 69036      Permit No. 50009....  
IN NAME OF

..... SUSAN McAULIFFE, E.TAL

Surveyed Sept. 20, 1988, by J. KAUPPILA.  
Sept. 17, 1990, by B. BISHOP