


T. 26 S., R. 13 W., W. M.

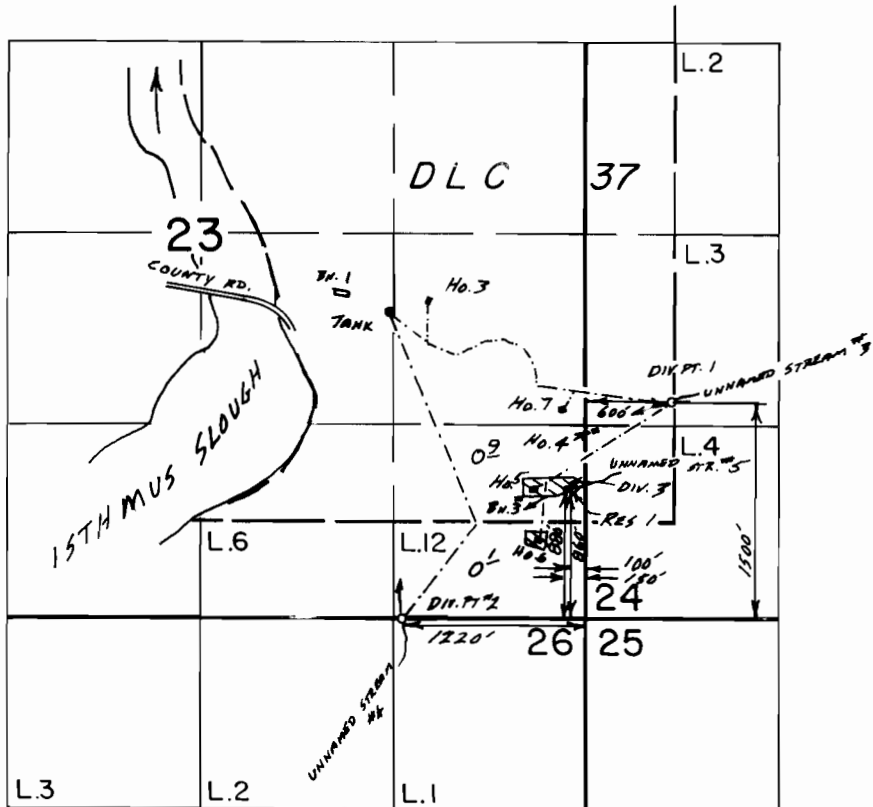

Scale : 1" = 1320'

FINAL PROOF SURVEY
UNDER

R-69035 R-10827

Application No. ~~69036~~ Permit No. ~~50009~~....

IN NAME OF

..... SUSAN McAULIFFE, E.TAL

Surveyed Sept. 20, 1988, by J. KAUPPILA.
Sept. 17, 1990, by B. BISHOP