



T. 6 S., R. 39 E., W. 1 M.

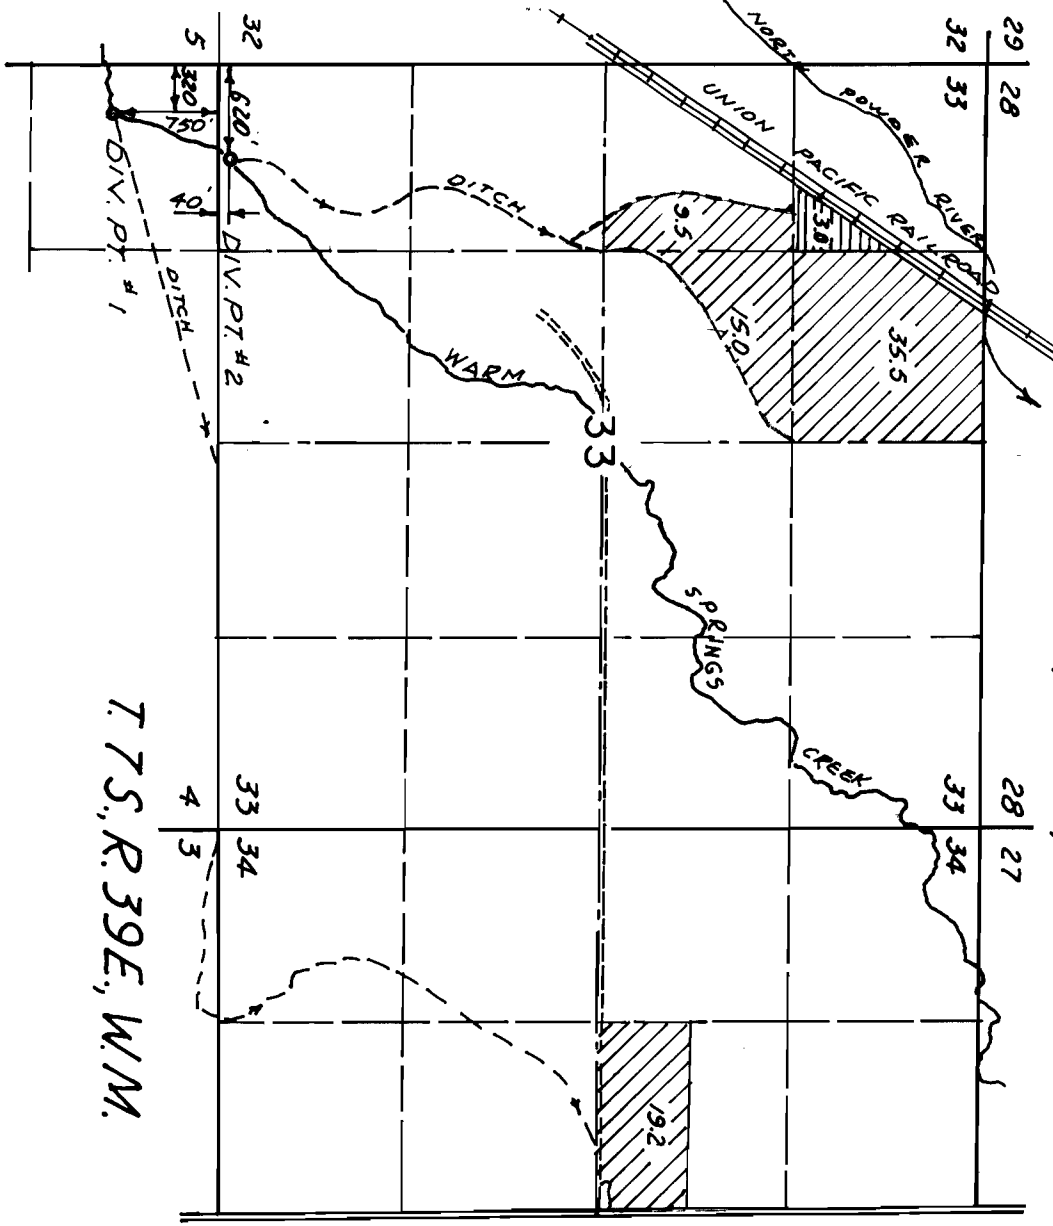

THE PURPOSE OF THIS MAP IS FOR IDENTIFYING THE LOCATION OF THE WATER RIGHT ONLY AND IS NOT INTENDED TO PROVIDE LEGAL DIMENSIONS OF PROPERTY OWNERSHIP LINES.

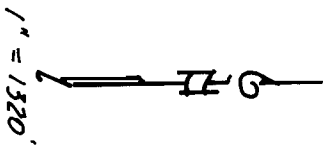

T. 7 S., R. 39 E., W. 1 M.

 SUPPLEMENTAL  
 PRIMARY

# FINAL PROOF SURVEY UNDER

Application No. 70030 Permit No. 51045.  
 IN NAME OF  
**PETER W. SCHOENINGH, JR.**

Surveyed October 8, 1990

