


T.28S., R.14W., W.M.

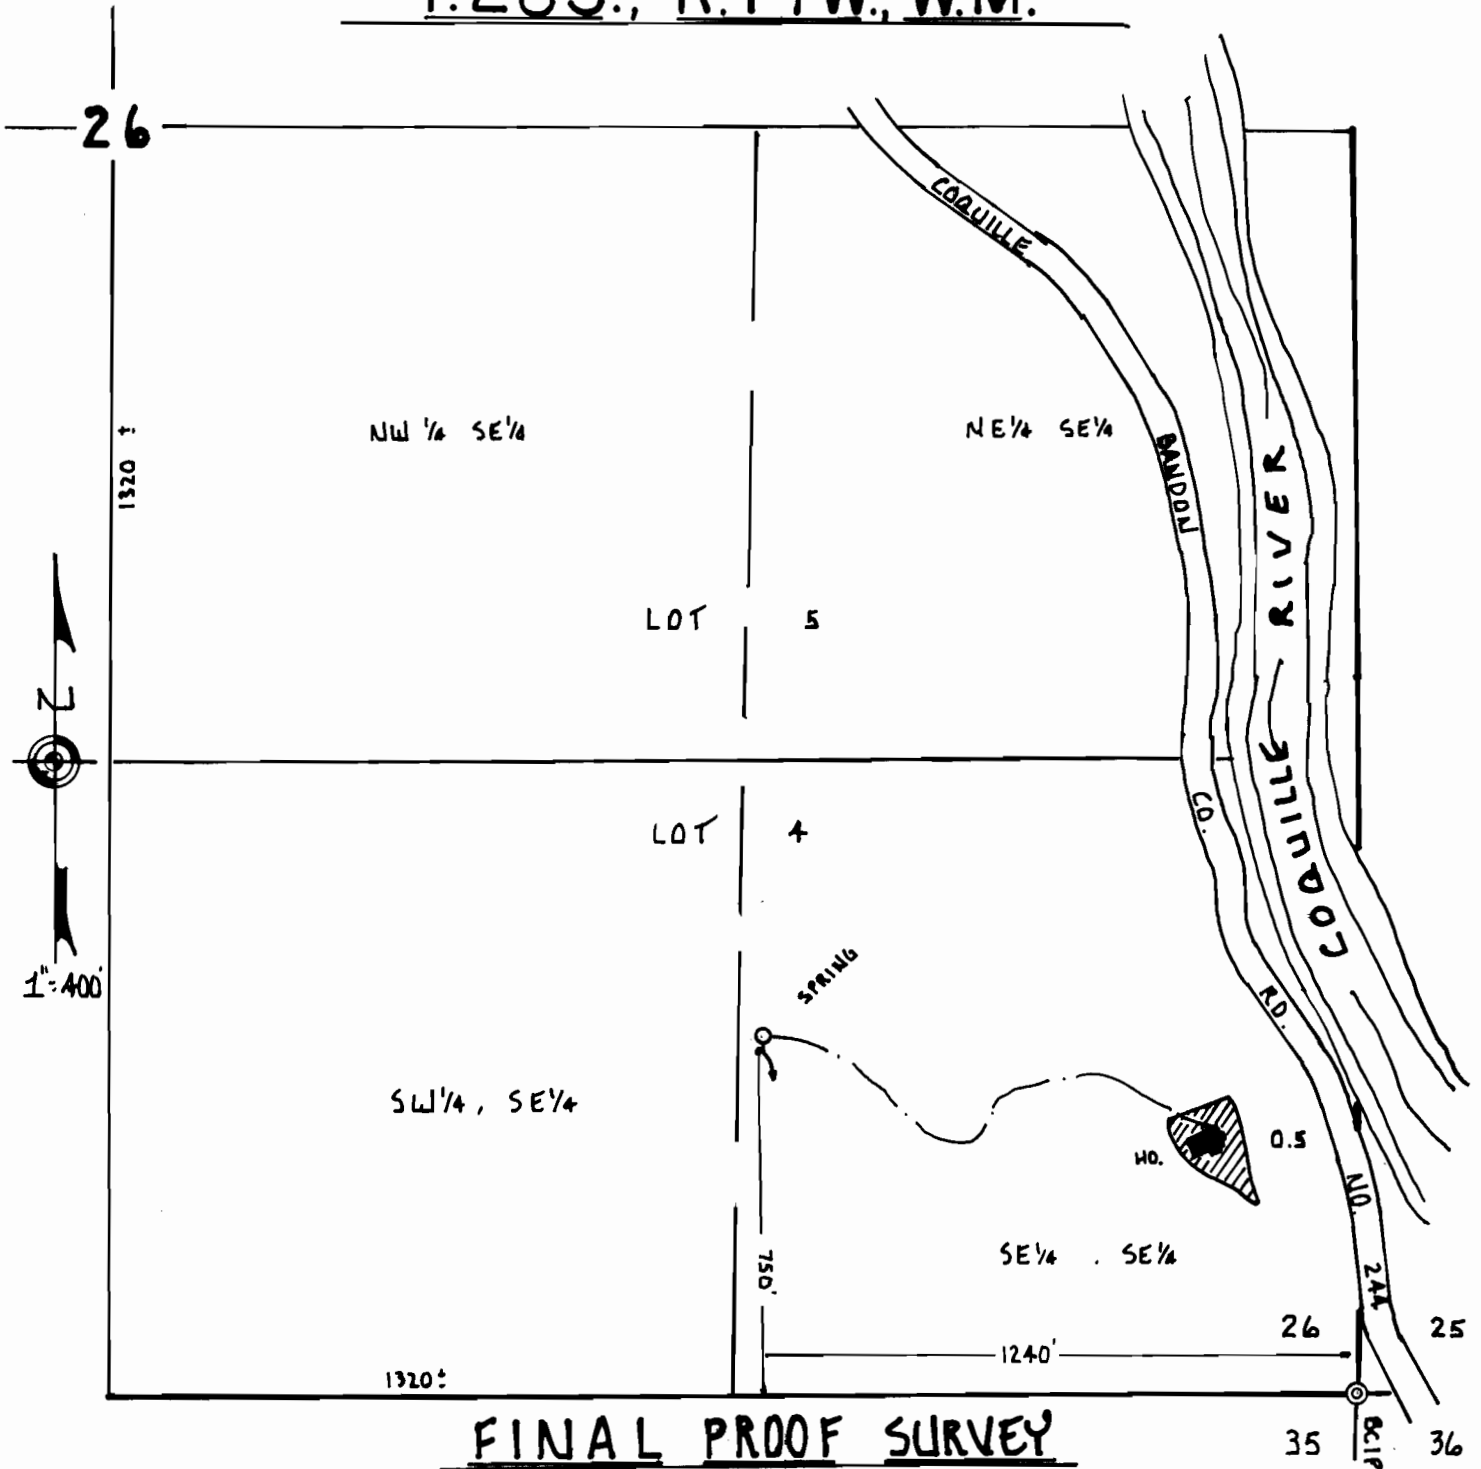

FINAL PROOF SURVEY

UNDER

APPLICATION 70508 PERMIT NO 51113

IN NAME OF

ROBERT & BONNIE MOYER

SURVEYED: JUNE 3, 1992 BY: JOHN P. PRAHAR CWRE #107

THIS MAP WAS PREPARED FOR THE SOLE PURPOSE OF IDENTIFYING THE LOCATION OF A WATER RIGHT AND IS NOT INTENDED TO SHOW OWNERSHIP LINES.

