
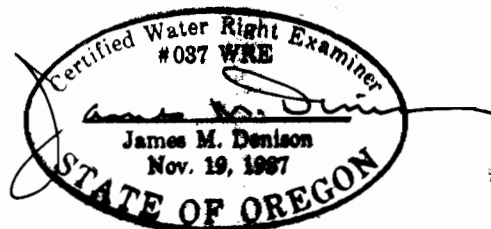


RECEIVED

SEP 24 1992

WATER RESOURCES DEPT.
SALEM, OREGON

**T.11 S.R.11 W..W.M.
Section 4
Lincoln County, Oregon**

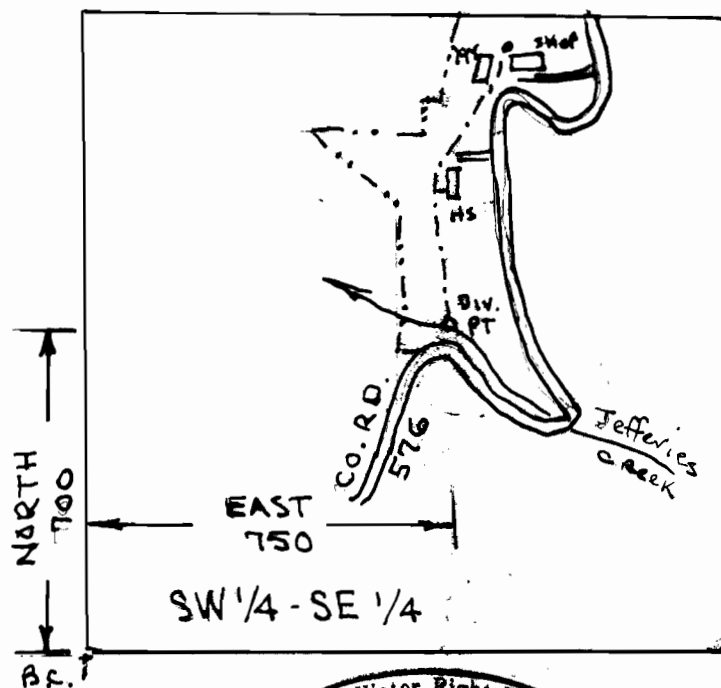

**FINAL PROOF SURVEY
UNDER**

APPLICATION #70509
IN THE NAME OF
DAVID C. PETERSON

PERMIT # 51195

SURVEYED 08-26-91

BY J.M. Denison

This map prepared solely for the purpose of showing location of a water right, and is not intended for use to provide dimensions or location of property ownership lines.