


T. 17 S., R. 18 E., W.M.

C 68074

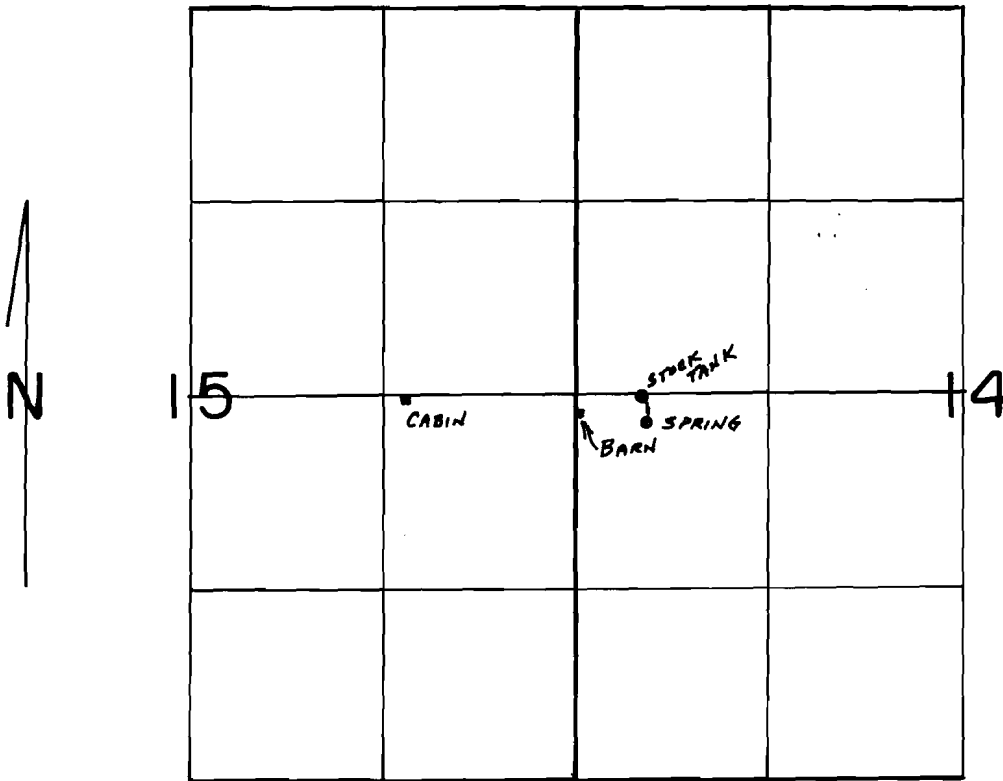

SPRING LOC: 190'S. & 480'E. FROM W. 1/4 COR SEC. 14

SCALE: 1"= 1320'

FINAL PROOF SURVEY

UNDER

Application No. 48677 Permit No. 36499
IN NAME OF

Cert. 68074

EARLE WARREN SEARS

Surveyed AUG 3, 1988, by B.W. BISHOP

RECEIVED MAR 05 1993

9/30/92 *BWB*

41013-280-296 D

36499